


| LEGENDS |                  |
|---------|------------------|
| ST      | STORM WATER PIPE |
| SAN.    | SANITARY PIPE    |
| V       | VENT PIPE        |
| —       | VENT PIPE        |
| —       | SANITARY PIPE    |
| —       | STORM WATER PIPE |
| —       | FRESH AIR INLET  |
| TA      | TO ABOVE         |
| UP      | UPWARDS          |
| FD      | FLOOR DRAIN      |
| AD      | AREA DRAIN       |
| CODP    | FLOOR CLEANOUT   |
| PD      | PLANTED DRAIN    |
| IL      | INVERT LEVEL     |

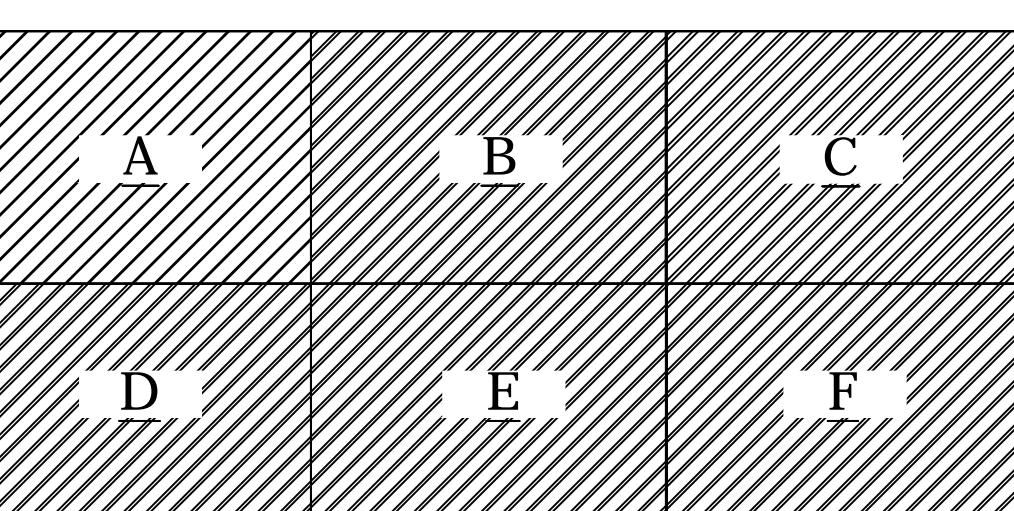

## Key Plan

## NOTE TO ARCHITECT OR ENGINEER

THIS DRAWING IS A REPRESENTATION OF A PROPOSED LAYOUT. IT IS THE CONTRACTOR'S RESPONSIBILITY TO VERIFY AND REVIEW THIS TO FINAL SUBMISSION. CADSULTANTS IS NOT RESPONSIBLE FOR DISCREPANCIES IN THE FIELD. ANY CORRECTIONS TO THE DRAWING IS REQUIRED BY THE CONTRACTOR TO ADVISE CADSULTANTS BY A RED-LINED DRAWING. CADSULTANTS IS NOT RESPONSIBLE FOR SUBMISSION, BEING FABRICATED & INSTALLED. ANY CHANGE FROM ORIGINAL ENGINEERING CONTRACT DRAWING MAY RESULT IN ADDITIONAL COSTS FOR RE-DRAFTING SUCH AS CHANGE ORDERS, DESIGN CHANGES, EQUIPMENT CHANGE OUT OR RELOCATIONS. ADDITIONAL SURVEY MAY BE NECESSARY. CADSULTANTS IS NOT RESPONSIBLE FOR ANY BACK CHARGES.

02 03-20-2020 Updated for comments/re-issued for review-pit removed

01 03-03-2020 Issued for review

NO. DATE: DESCRIPTION:

REVISIONS

MECHANICAL CONTRACTOR:

DRAFTING COMPANY  
Professional Drafting Services  
Certified / Insured CAD Specialists  
Marc W. Hoffman

167 Allen Road  
Rockville Centre NY, 11570  
Contact: 646.641.2512  
Email: Caddconsultant@mail.com


DRAWING TITLE :

PLUMBING UNDERGROUND  
FLOOR PLAN

PROJECT INFORMATION:


Scale: - 0'-0"-1/8"-1'-0" Date: 03/03/20 Drawing Number

PAGE-36x48 P-100

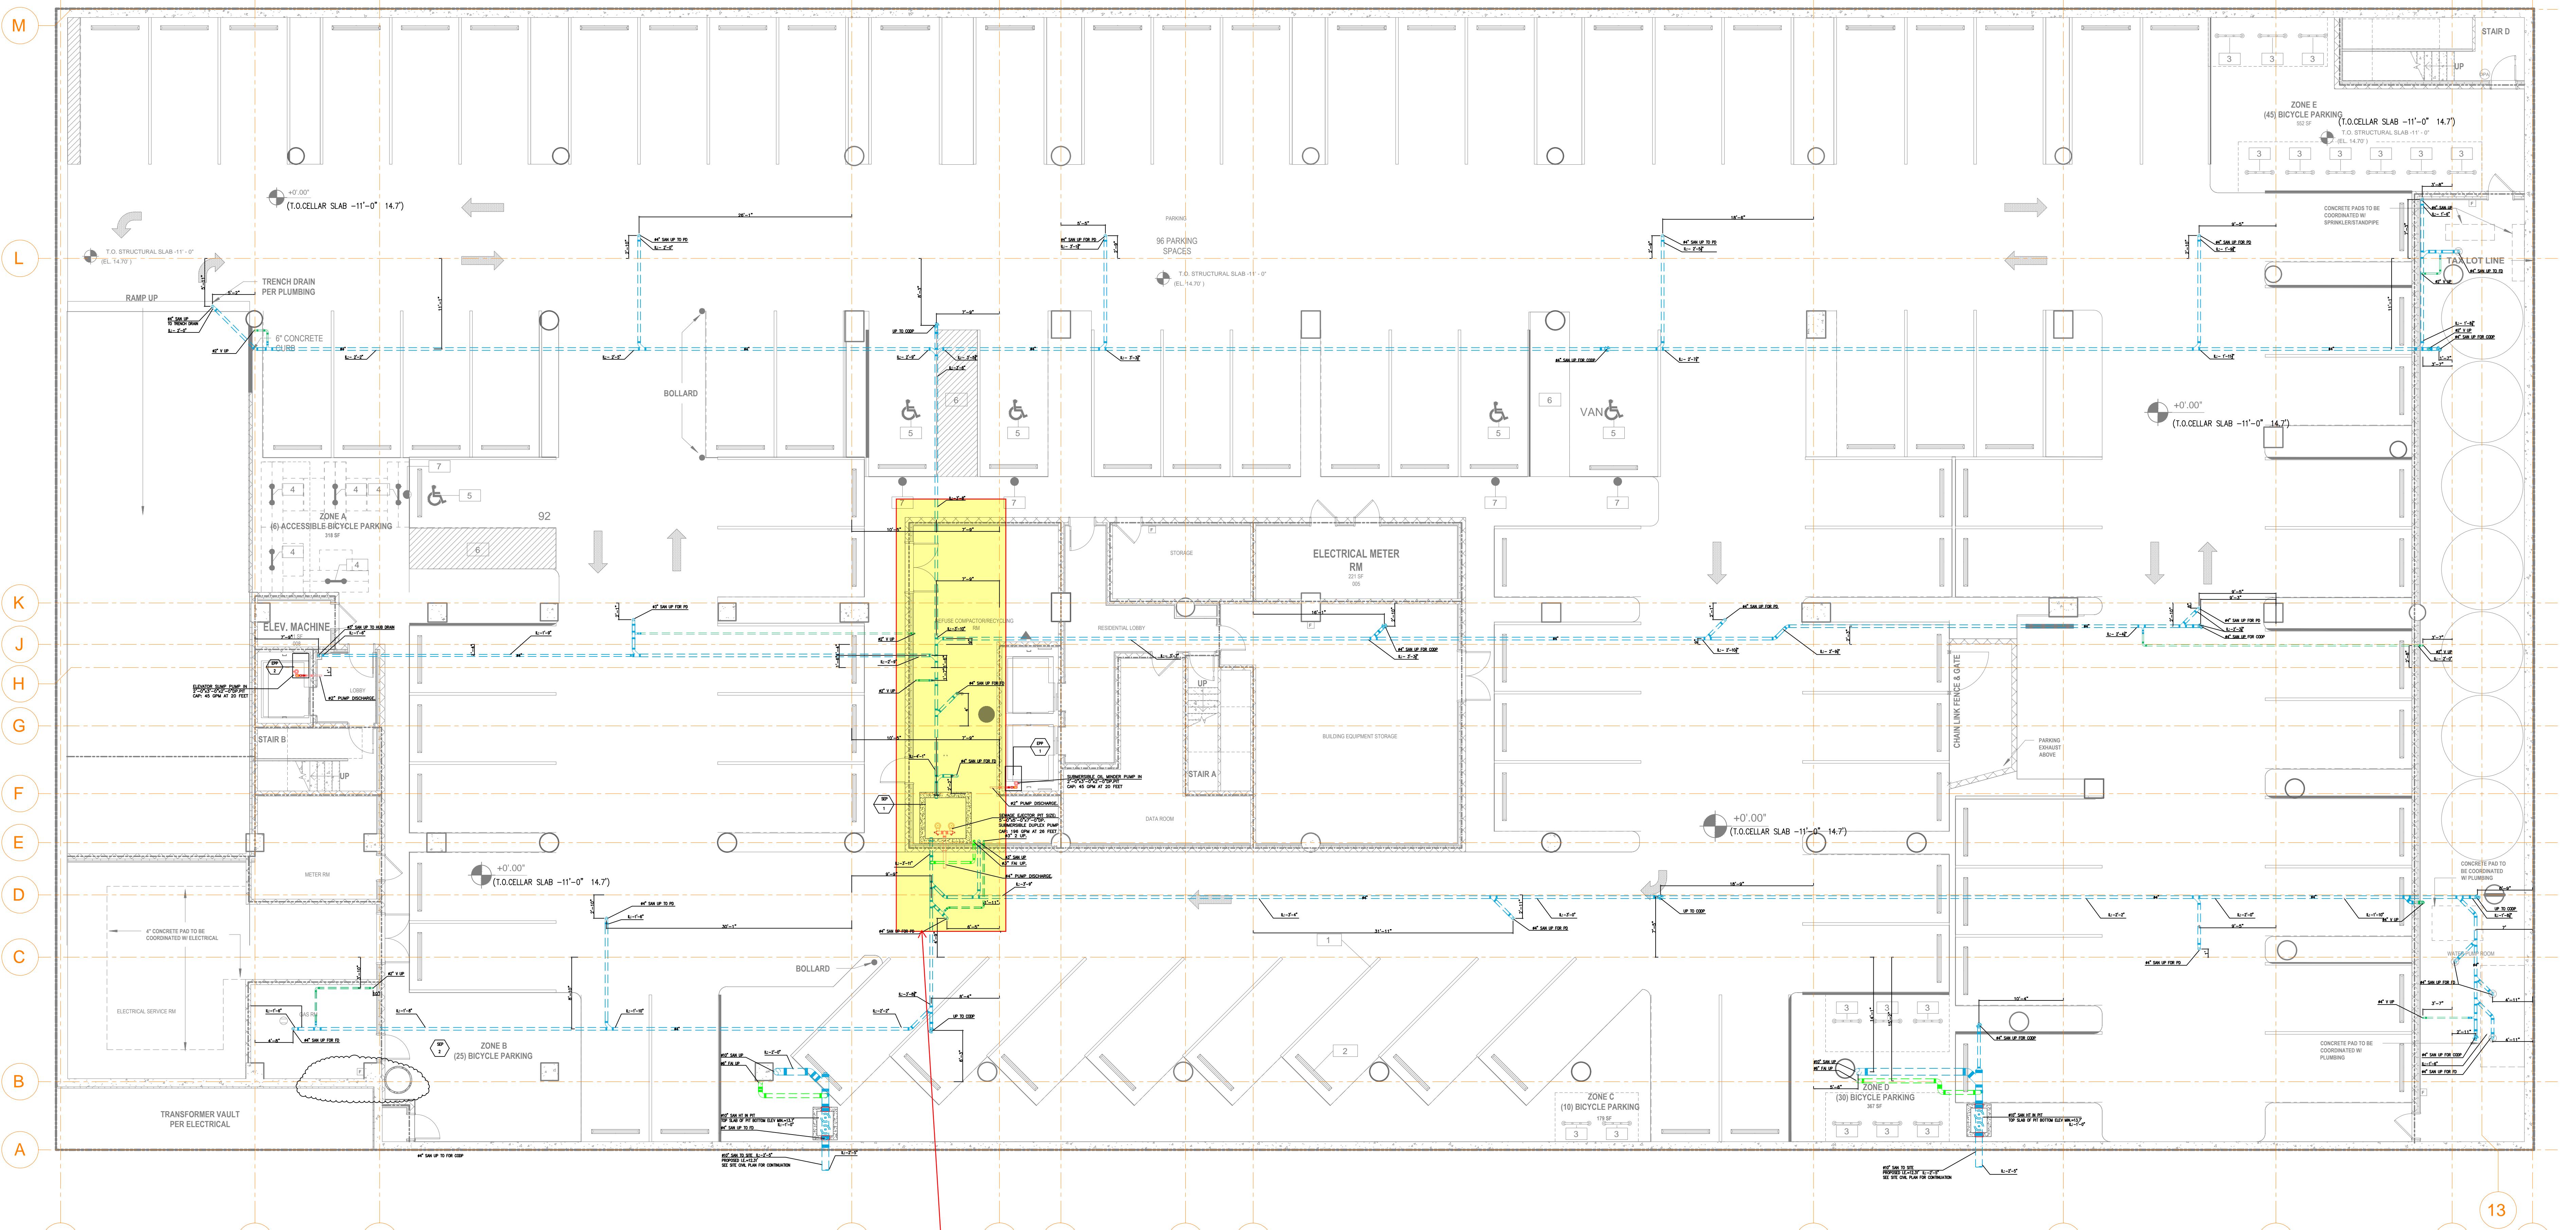

ALL PIPE ELEVATION ON THIS DRAWING MEASURED FROM CELLAR TOP OF SLAB 0.0 - BUILDING -11'-0" = 14.7')

Refer to Submittal #03 20 00-UCI-016-Rebar Shop Drawings- Underground Plumbing Reinforcement

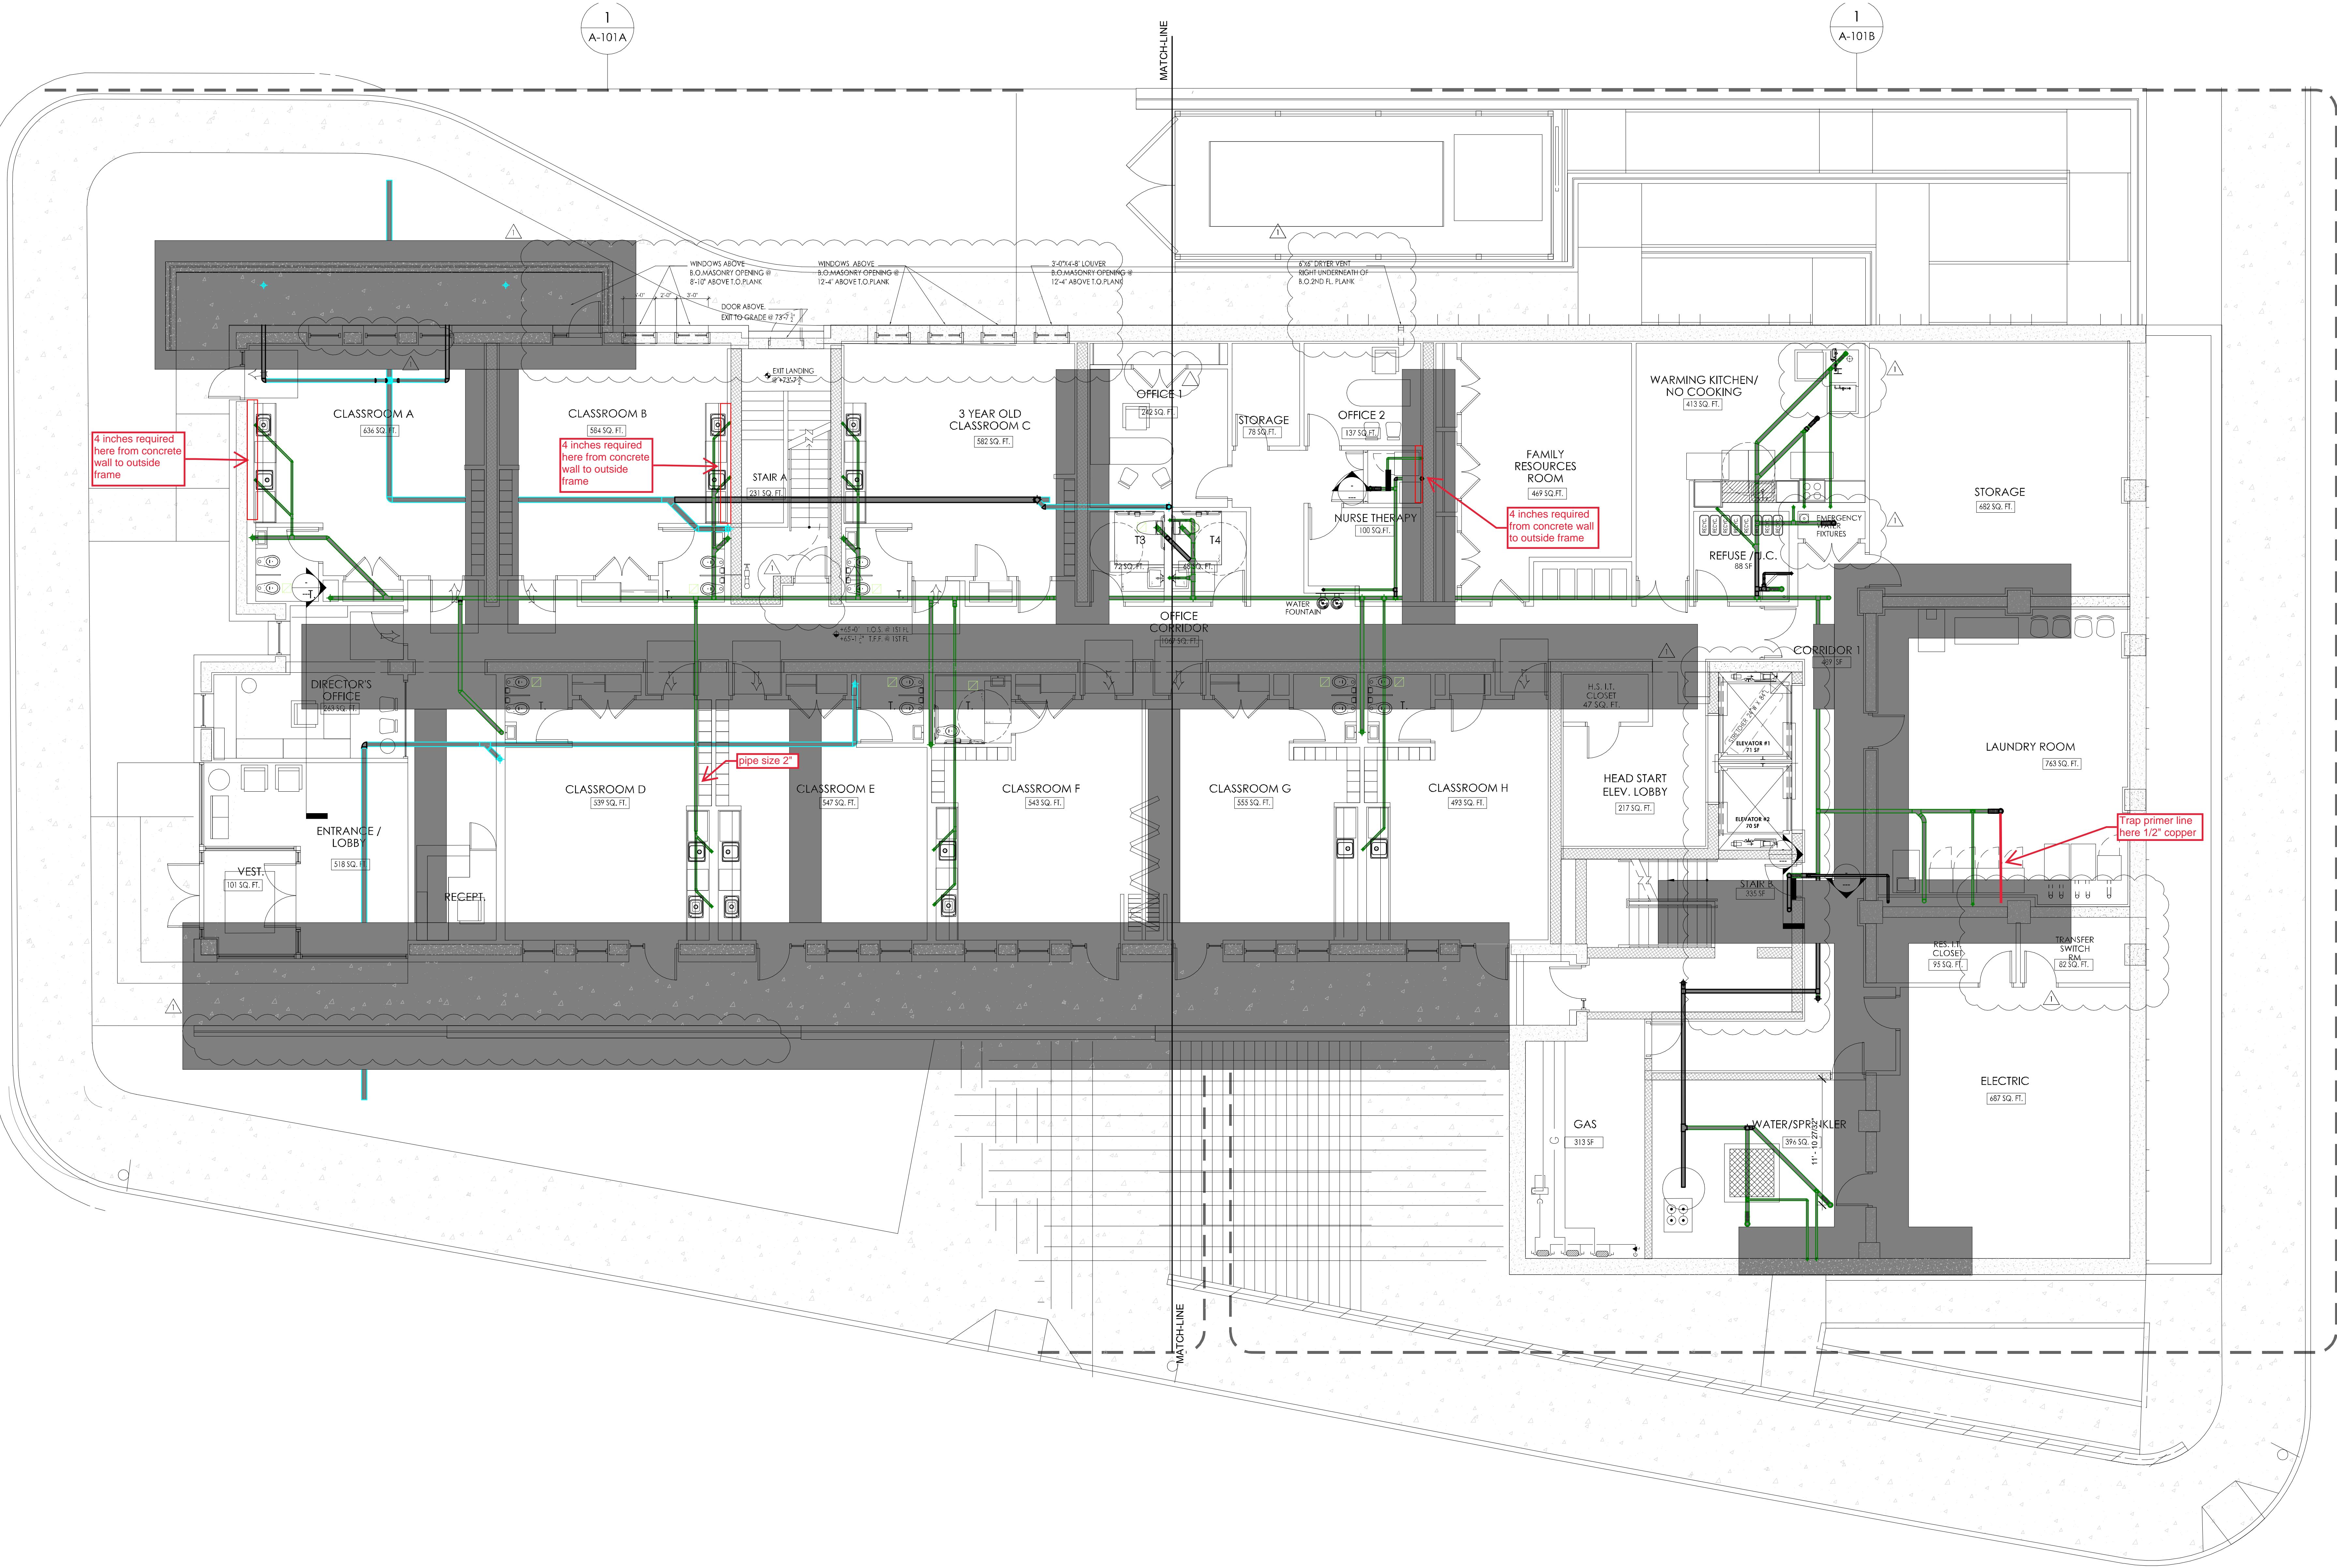

1ST FLOOR UNDERGROUND OVERALL  
① PLUMBING  
3/16" = 1'-0"

█████ will prepare Coordination Drawings for the sole purpose of general coordination and conformance with the project requirements and the design intent as indicated in the Contract Documents. These Coordination Drawings shall become Subcontract Documents as defined in the Subcontract Agreement. The work depicted within the Coordination Drawings does not relieve the Subcontractor of the responsibility for compliance with the Subcontract Documents and with any State, Federal or Local jurisdictional requirements. Nor shall these drawings be considered a replacement for the responsibilities associated with fabrication, means, methods, techniques, sequence, operations, erection, performance, or safety of systems that remain the sole responsibility of the Subcontractor. Sole responsibility for correctness of dimensions, details, quantity for fabrication, construction, erection, installation and performance shall remain the sole responsibility of the Subcontractor. By authorizing below, the Subcontractor represents that they have fully reviewed the Coordination Drawings and verify that any and all errors, omissions or discrepancies that they are aware of, have been fully resolved and those resolutions are represented within these Coordination Drawings.

#### UNDERGROUND PIPEING ON ARCH BACKGROUND


PROJECT NO. 01  
DRAWN BY: A.V.  
CHECKED BY: A.P.  
ENGINEER REVIEW STAMP:  
DWG. NO:




Date: Trade: Signature:  
SIGNATURE SIGNIFIED ACCEPTANCE OF  
COORDINATED PLAN AS REVIEW BY EACH  
RESPECTED TRADE.


01/01/21 06  
04/01/21 04  
03/15/21 03  
02/11/2020 02  
11/01/2020 01  
No Date: Revision:  
SCALE:

DRAWING TITLE:

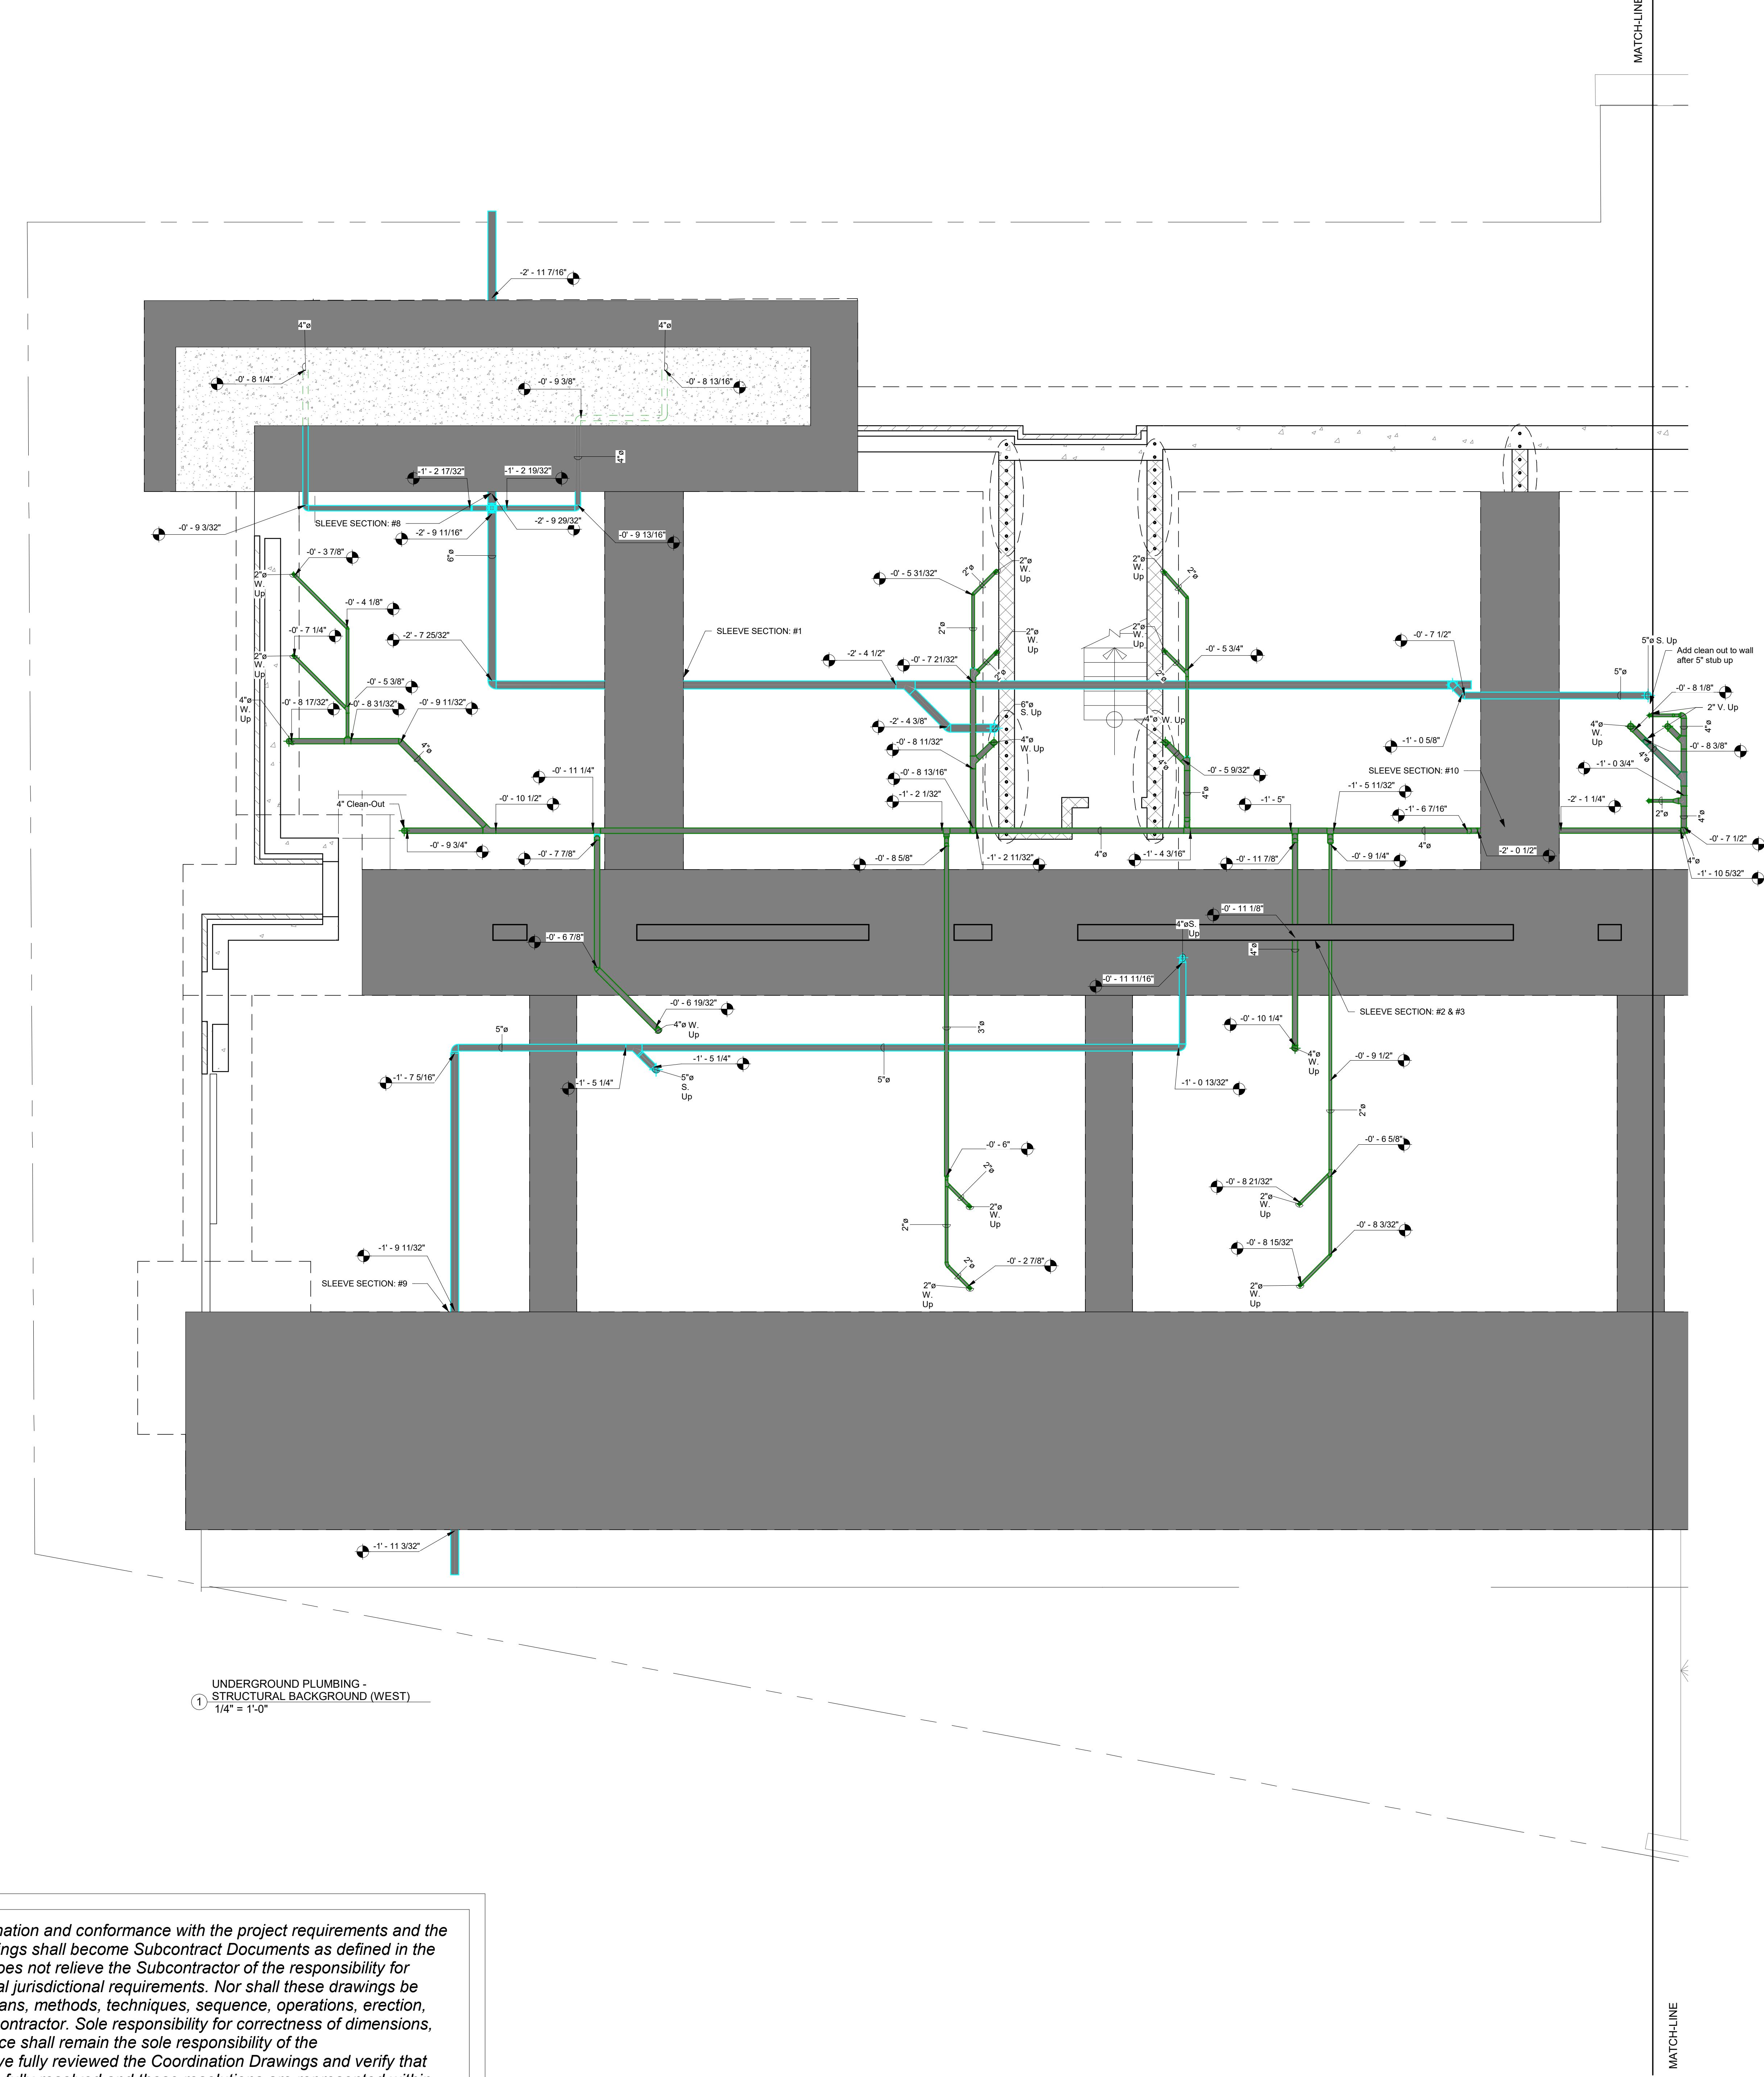

█████ will prepare Coordination Drawings for the sole purpose of general coordination and conformance with the project requirements and the design intent as indicated in the Contract Documents. These Coordination Drawings shall become Subcontract Documents as defined in the Subcontract Agreement. The work depicted within the Coordination Drawings does not relieve the Subcontractor of the responsibility for compliance with the Subcontract Documents and with any State, Federal or Local jurisdictional requirements. Nor shall these drawings be considered a replacement for the responsibilities associated with fabrication, means, methods, techniques, sequence, operations, erection, performance, or safety of systems that remain the sole responsibility of the Subcontractor. Sole responsibility for correctness of dimensions, details, quantity for fabrication, construction, erection, installation and performance shall remain the sole responsibility of the Subcontractor. By authorizing below, the Subcontractor represents that they have fully reviewed the Coordination Drawings and verify that any and all errors, omissions or discrepancies that they are aware of, have been fully resolved and those resolutions are represented within these Coordination Drawings.

 

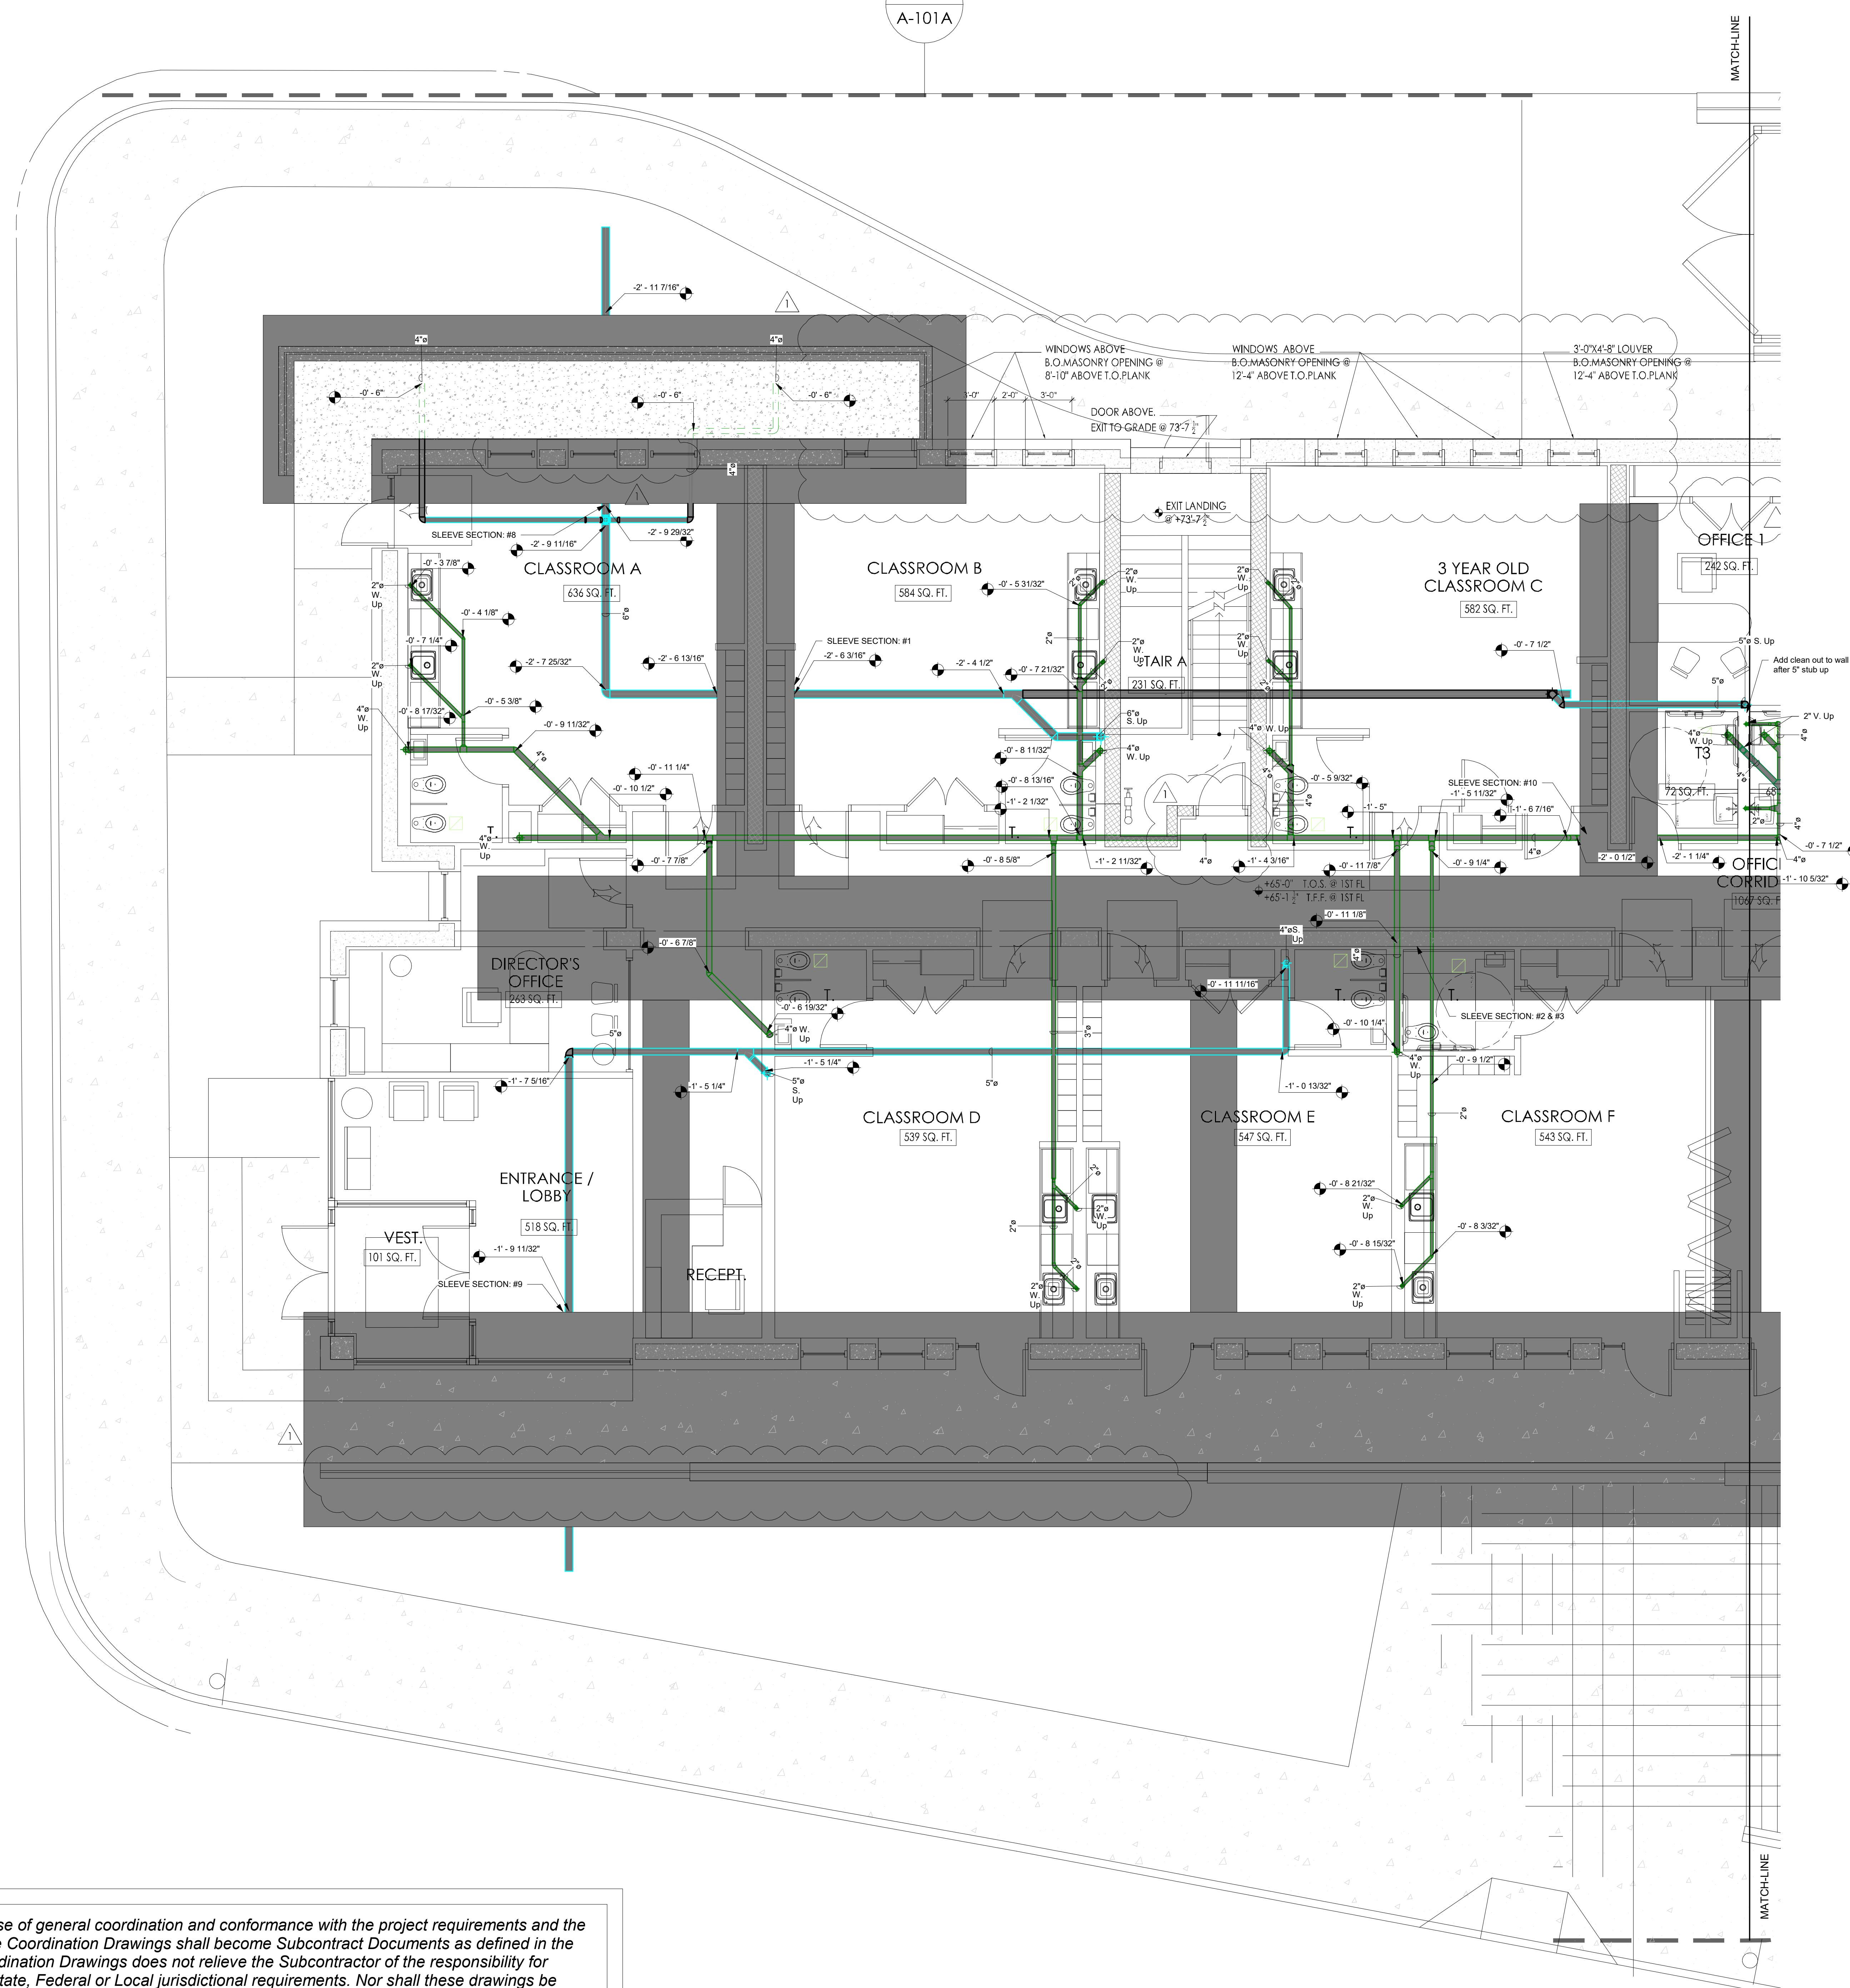

UNDERGROUND PLUMBING -  
ARCHITECTURAL BACKGROUND (WEST)

① 1/4" = 1'-0"

**█████** will prepare Coordination Drawings for the sole purpose of general coordination and conformance with the project requirements and the design intent as indicated in the Contract Documents. These Coordination Drawings shall become Subcontract Documents as defined in the Subcontract Agreement. The work depicted within the Coordination Drawings does not relieve the Subcontractor of the responsibility for compliance with the Subcontract Documents and with any State, Federal or Local jurisdictional requirements. Nor shall these drawings be considered a replacement for the responsibilities associated with fabrication, means, methods, techniques, sequence, operations, erection, performance, or safety of systems that remain the sole responsibility of the Subcontractor. Sole responsibility for correctness of dimensions, details, quantity for fabrication, construction, erection, installation and performance shall remain the sole responsibility of the Subcontractor. By authorizing below, the Subcontractor represents that they have fully reviewed the Coordination Drawings and verify that any and all errors, omissions or discrepancies that they are aware of, have been fully resolved and those resolutions are represented within these Coordination Drawings.

MATCHLINE //

MATCHLINE

MEP TRADES:  
PLUMBING:

FIRE PROTECTION:

MECHANICAL -

ELECTRICAL -


SIGNATURES:

Date : Trade: Signature:

SIGNATURE SIGNIFIED ACCEPTANCE OF  
COORDINATED PLAN AS REVIEW BY EACH  
RESPECTED TRADE.

08/09/2021 08  
04/12/2020 04  
03/11/2020 03  
11/11/2020 01  
No Date: Revision:  
SCALE:

KEY PLAN:

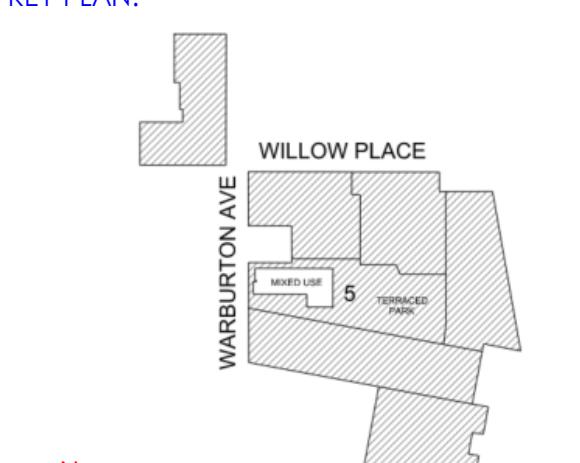










DRAWING TITLE:  
**UNDERGROUND  
PIPING ON ARCH  
BACKGROUND  
(WEST)**

PROJECT NO. 01  
DRAWN BY A.V.  
CHECKED BY A.P.  
DWG. NO. CP-04

ENGINEER REVIEW  
STAMP:

 CP-04



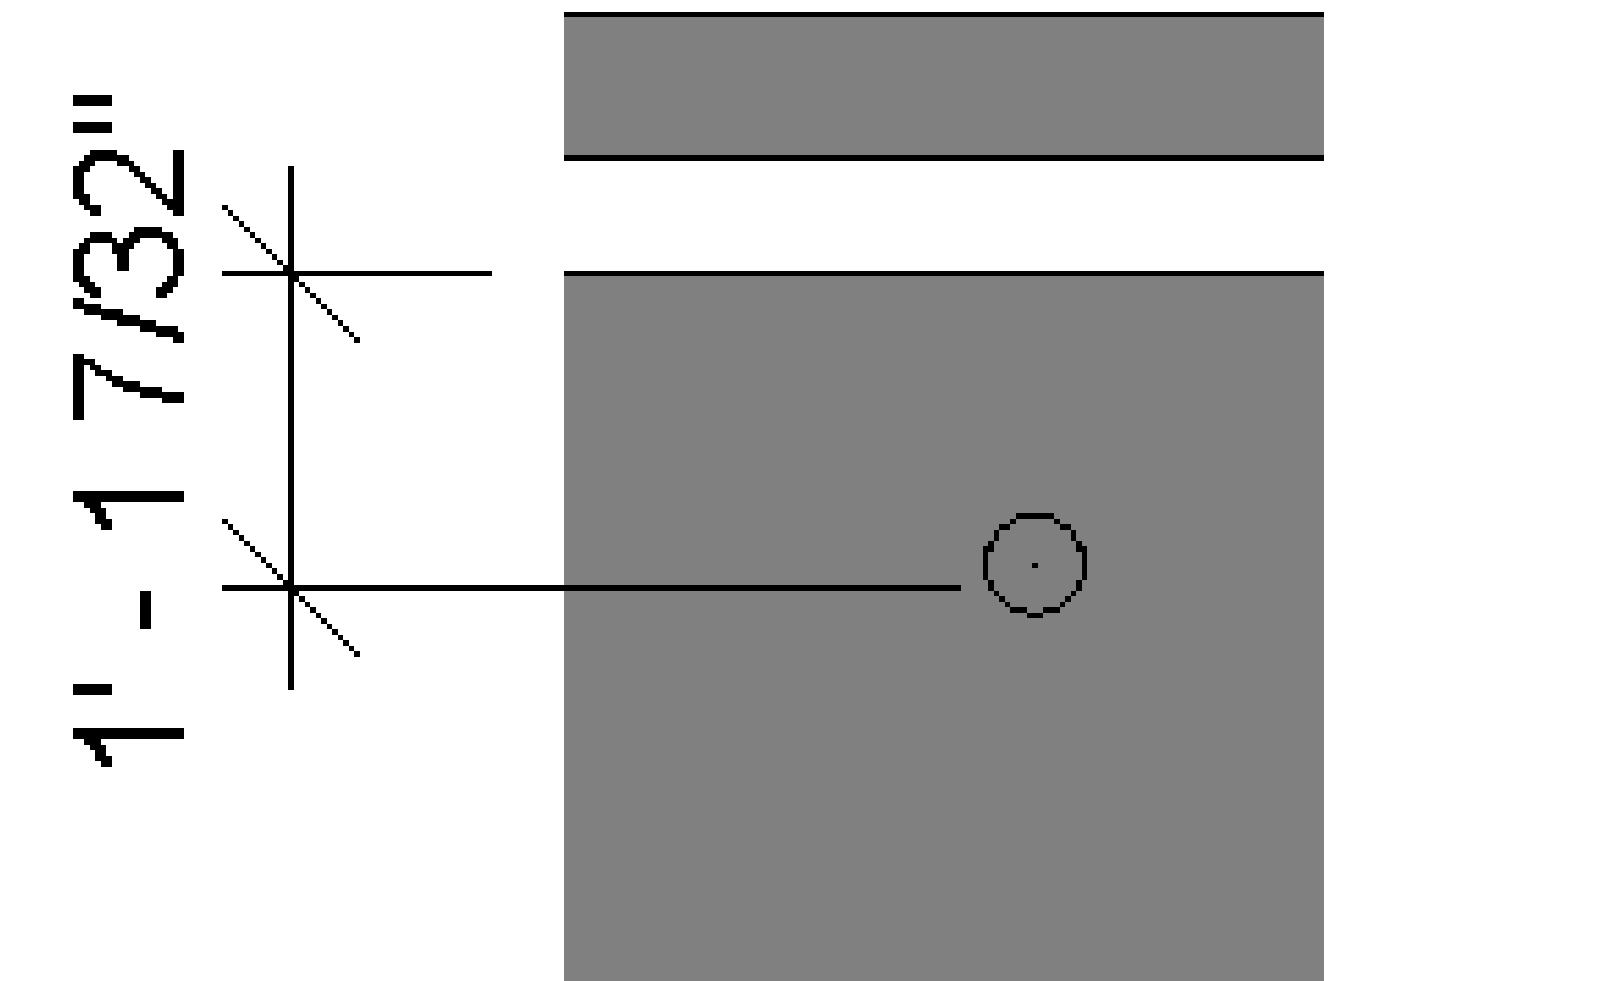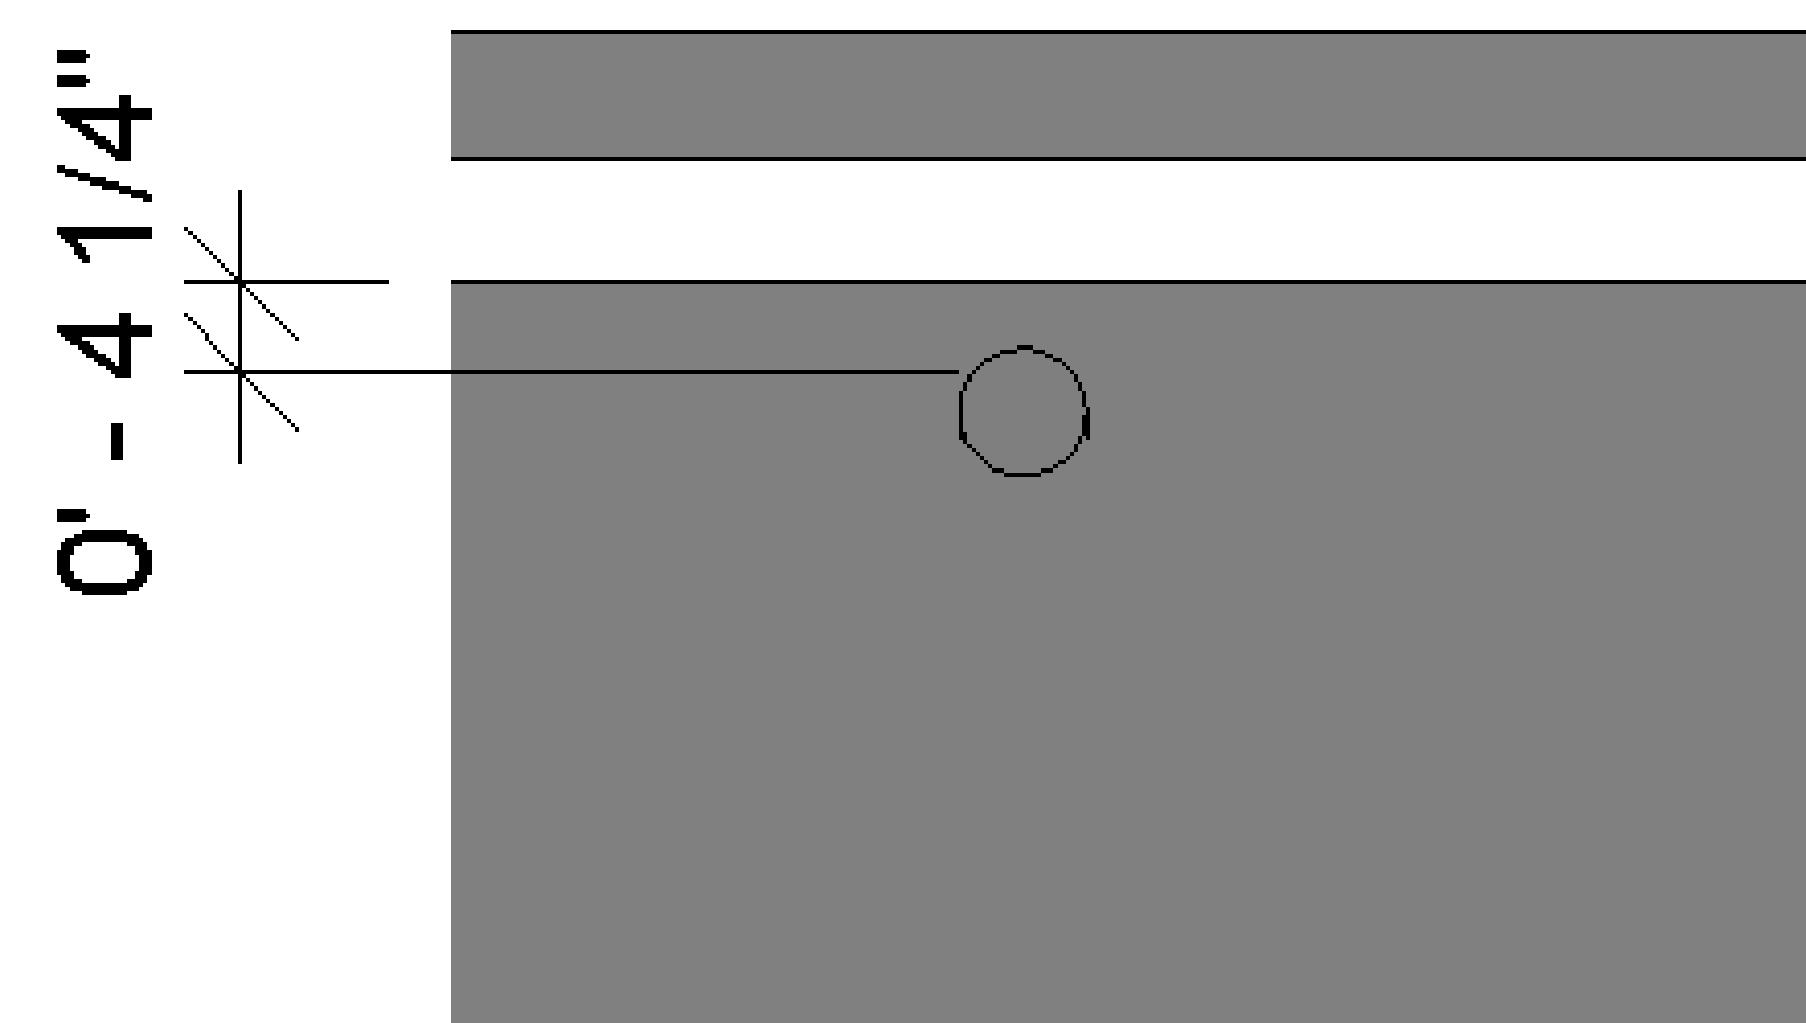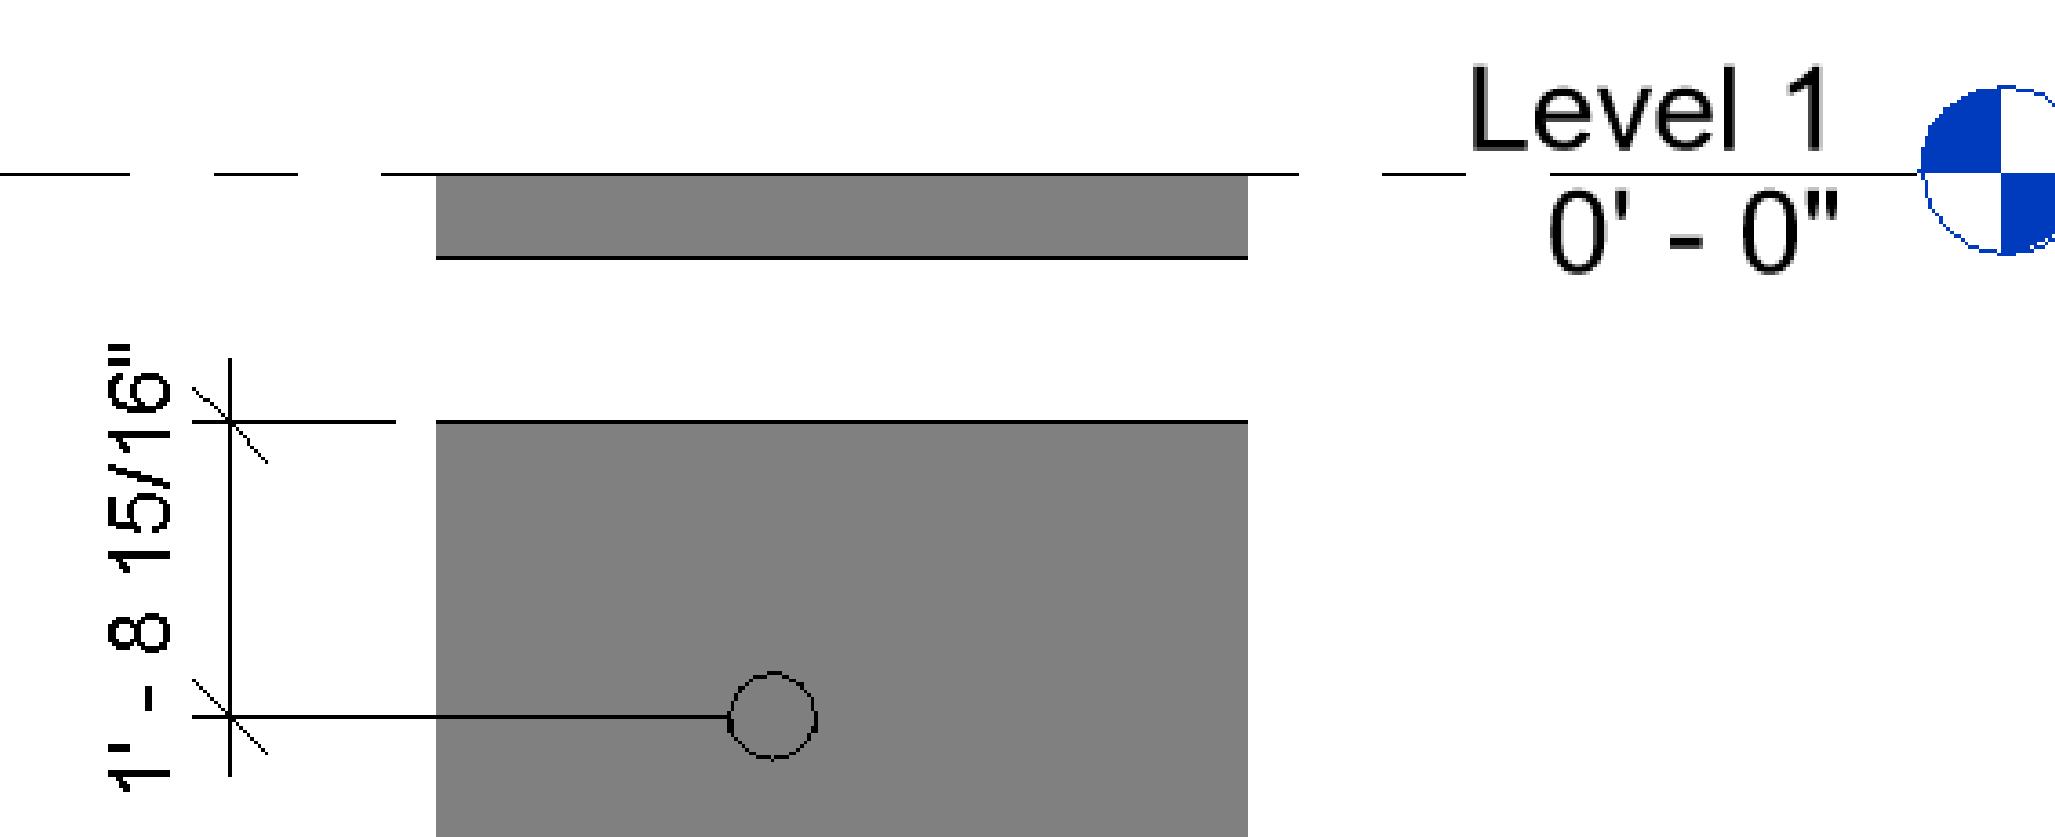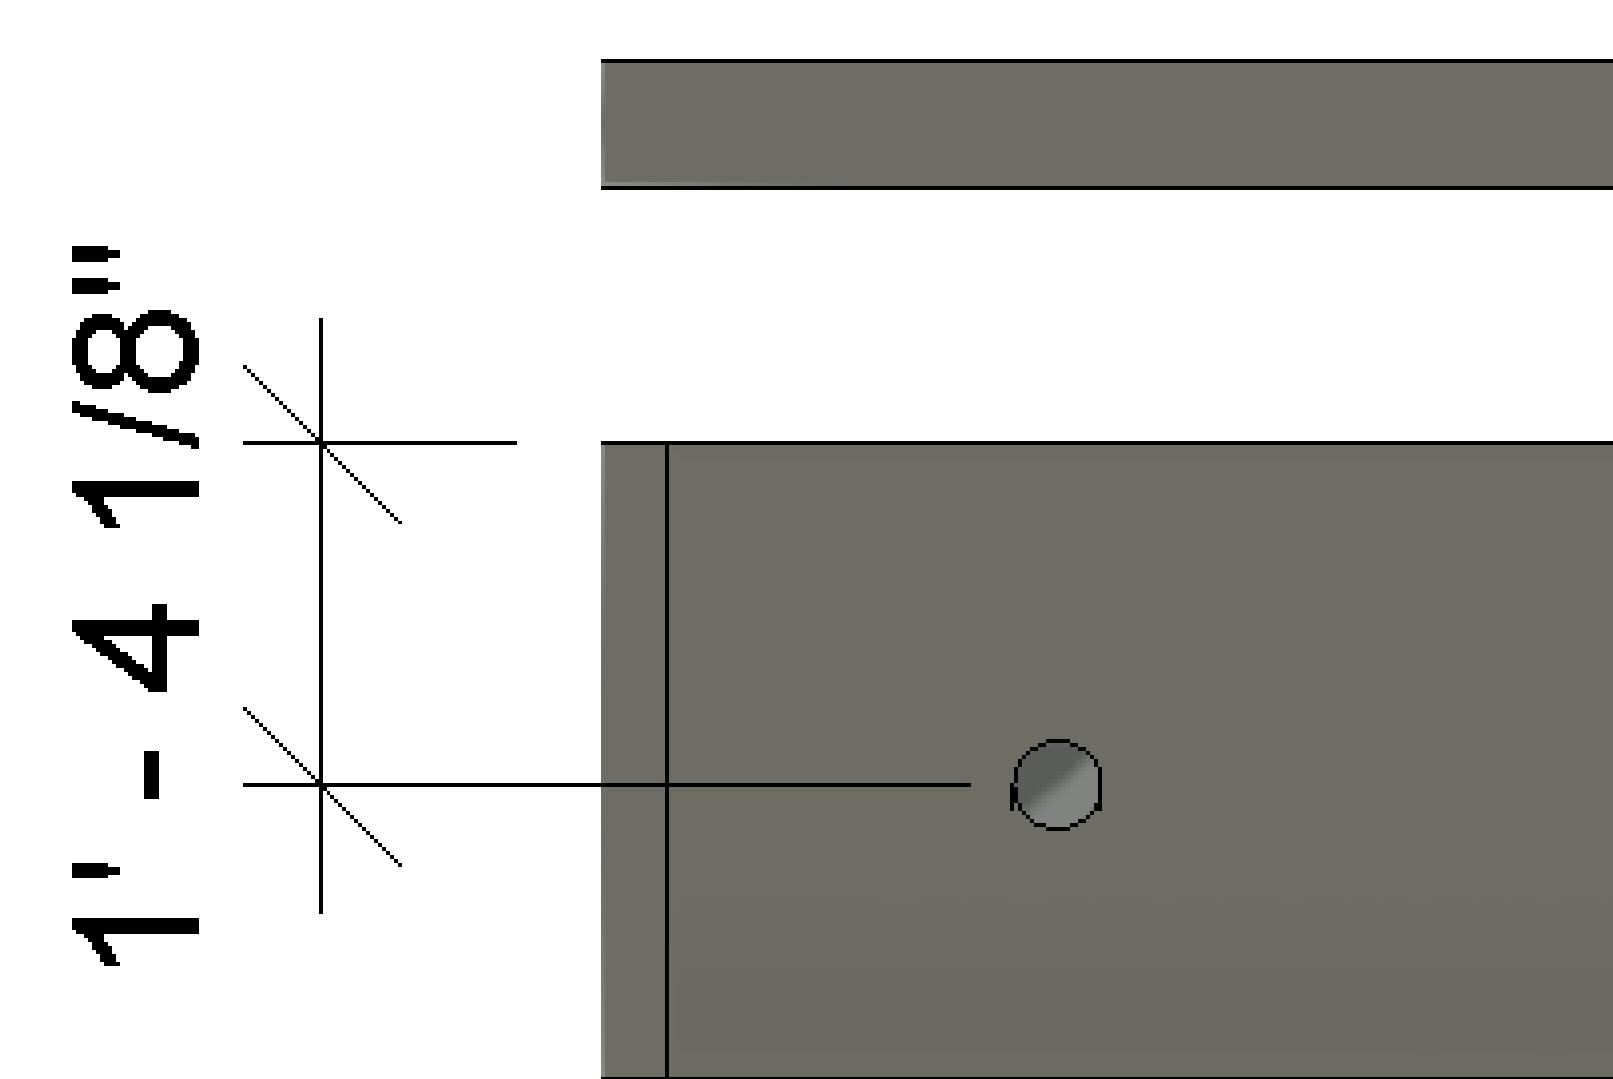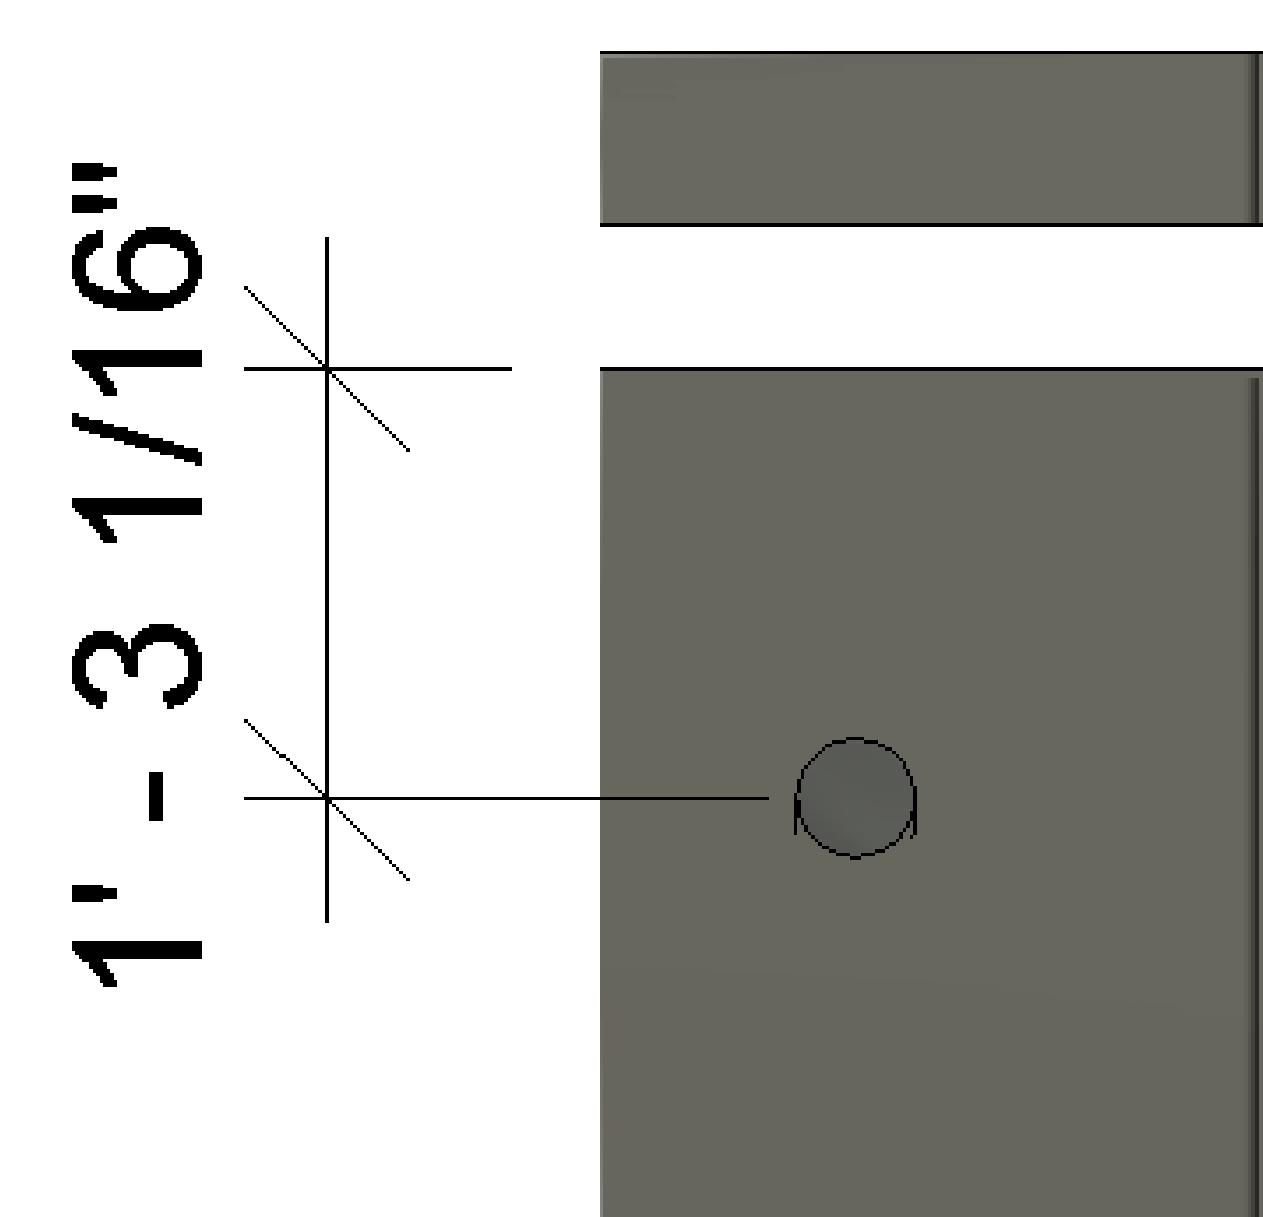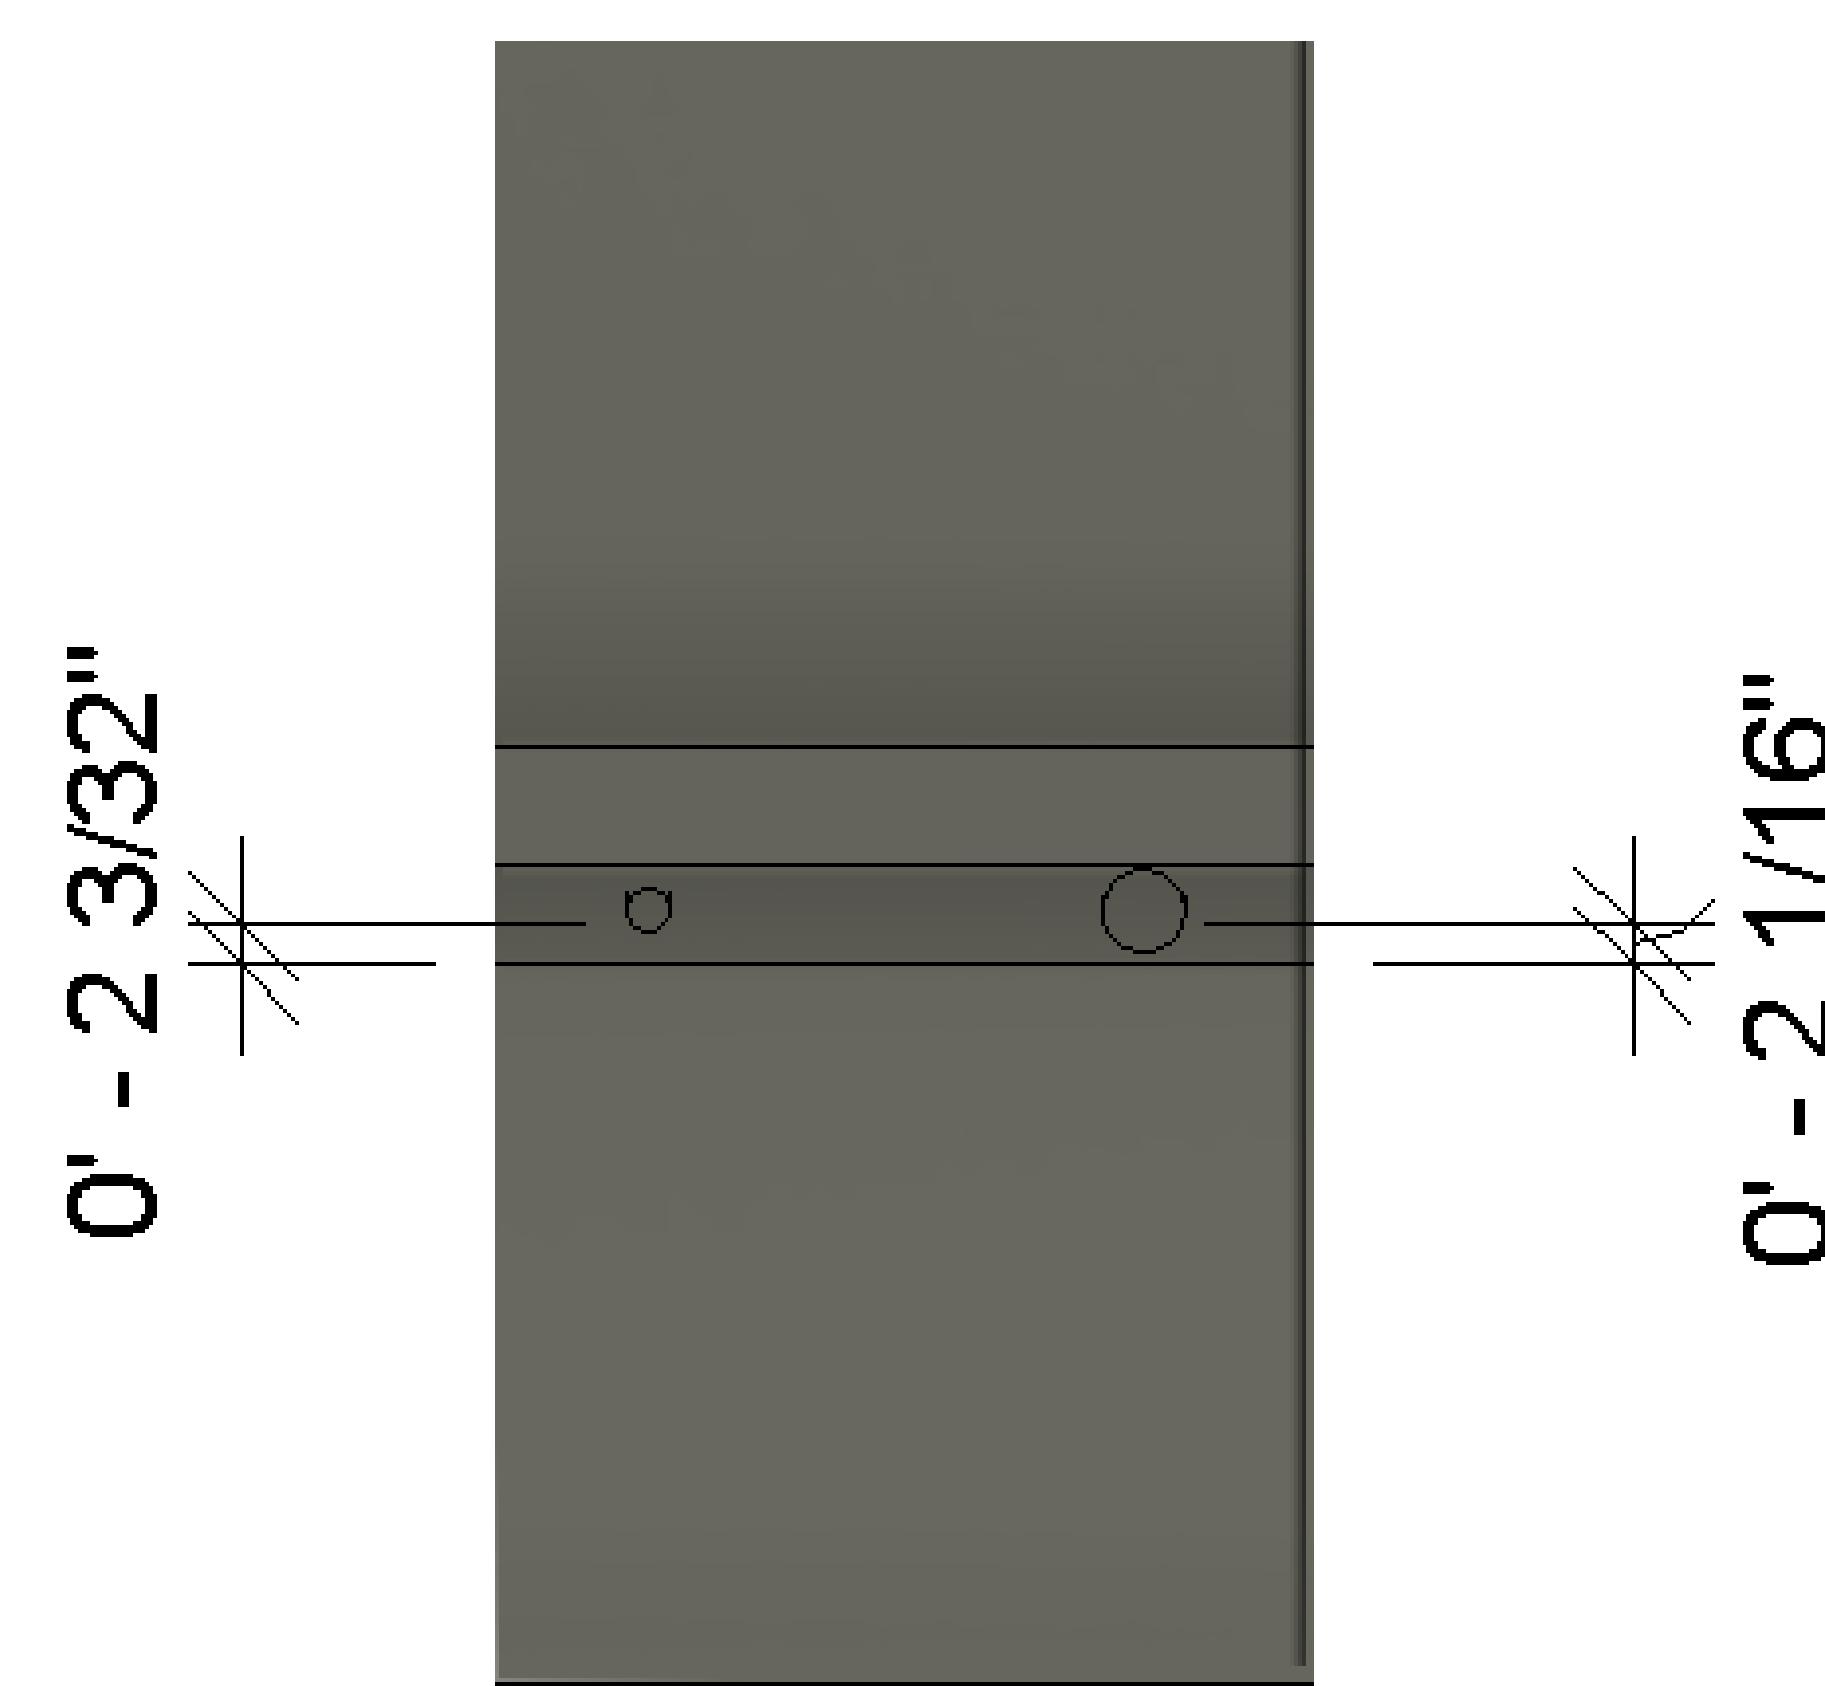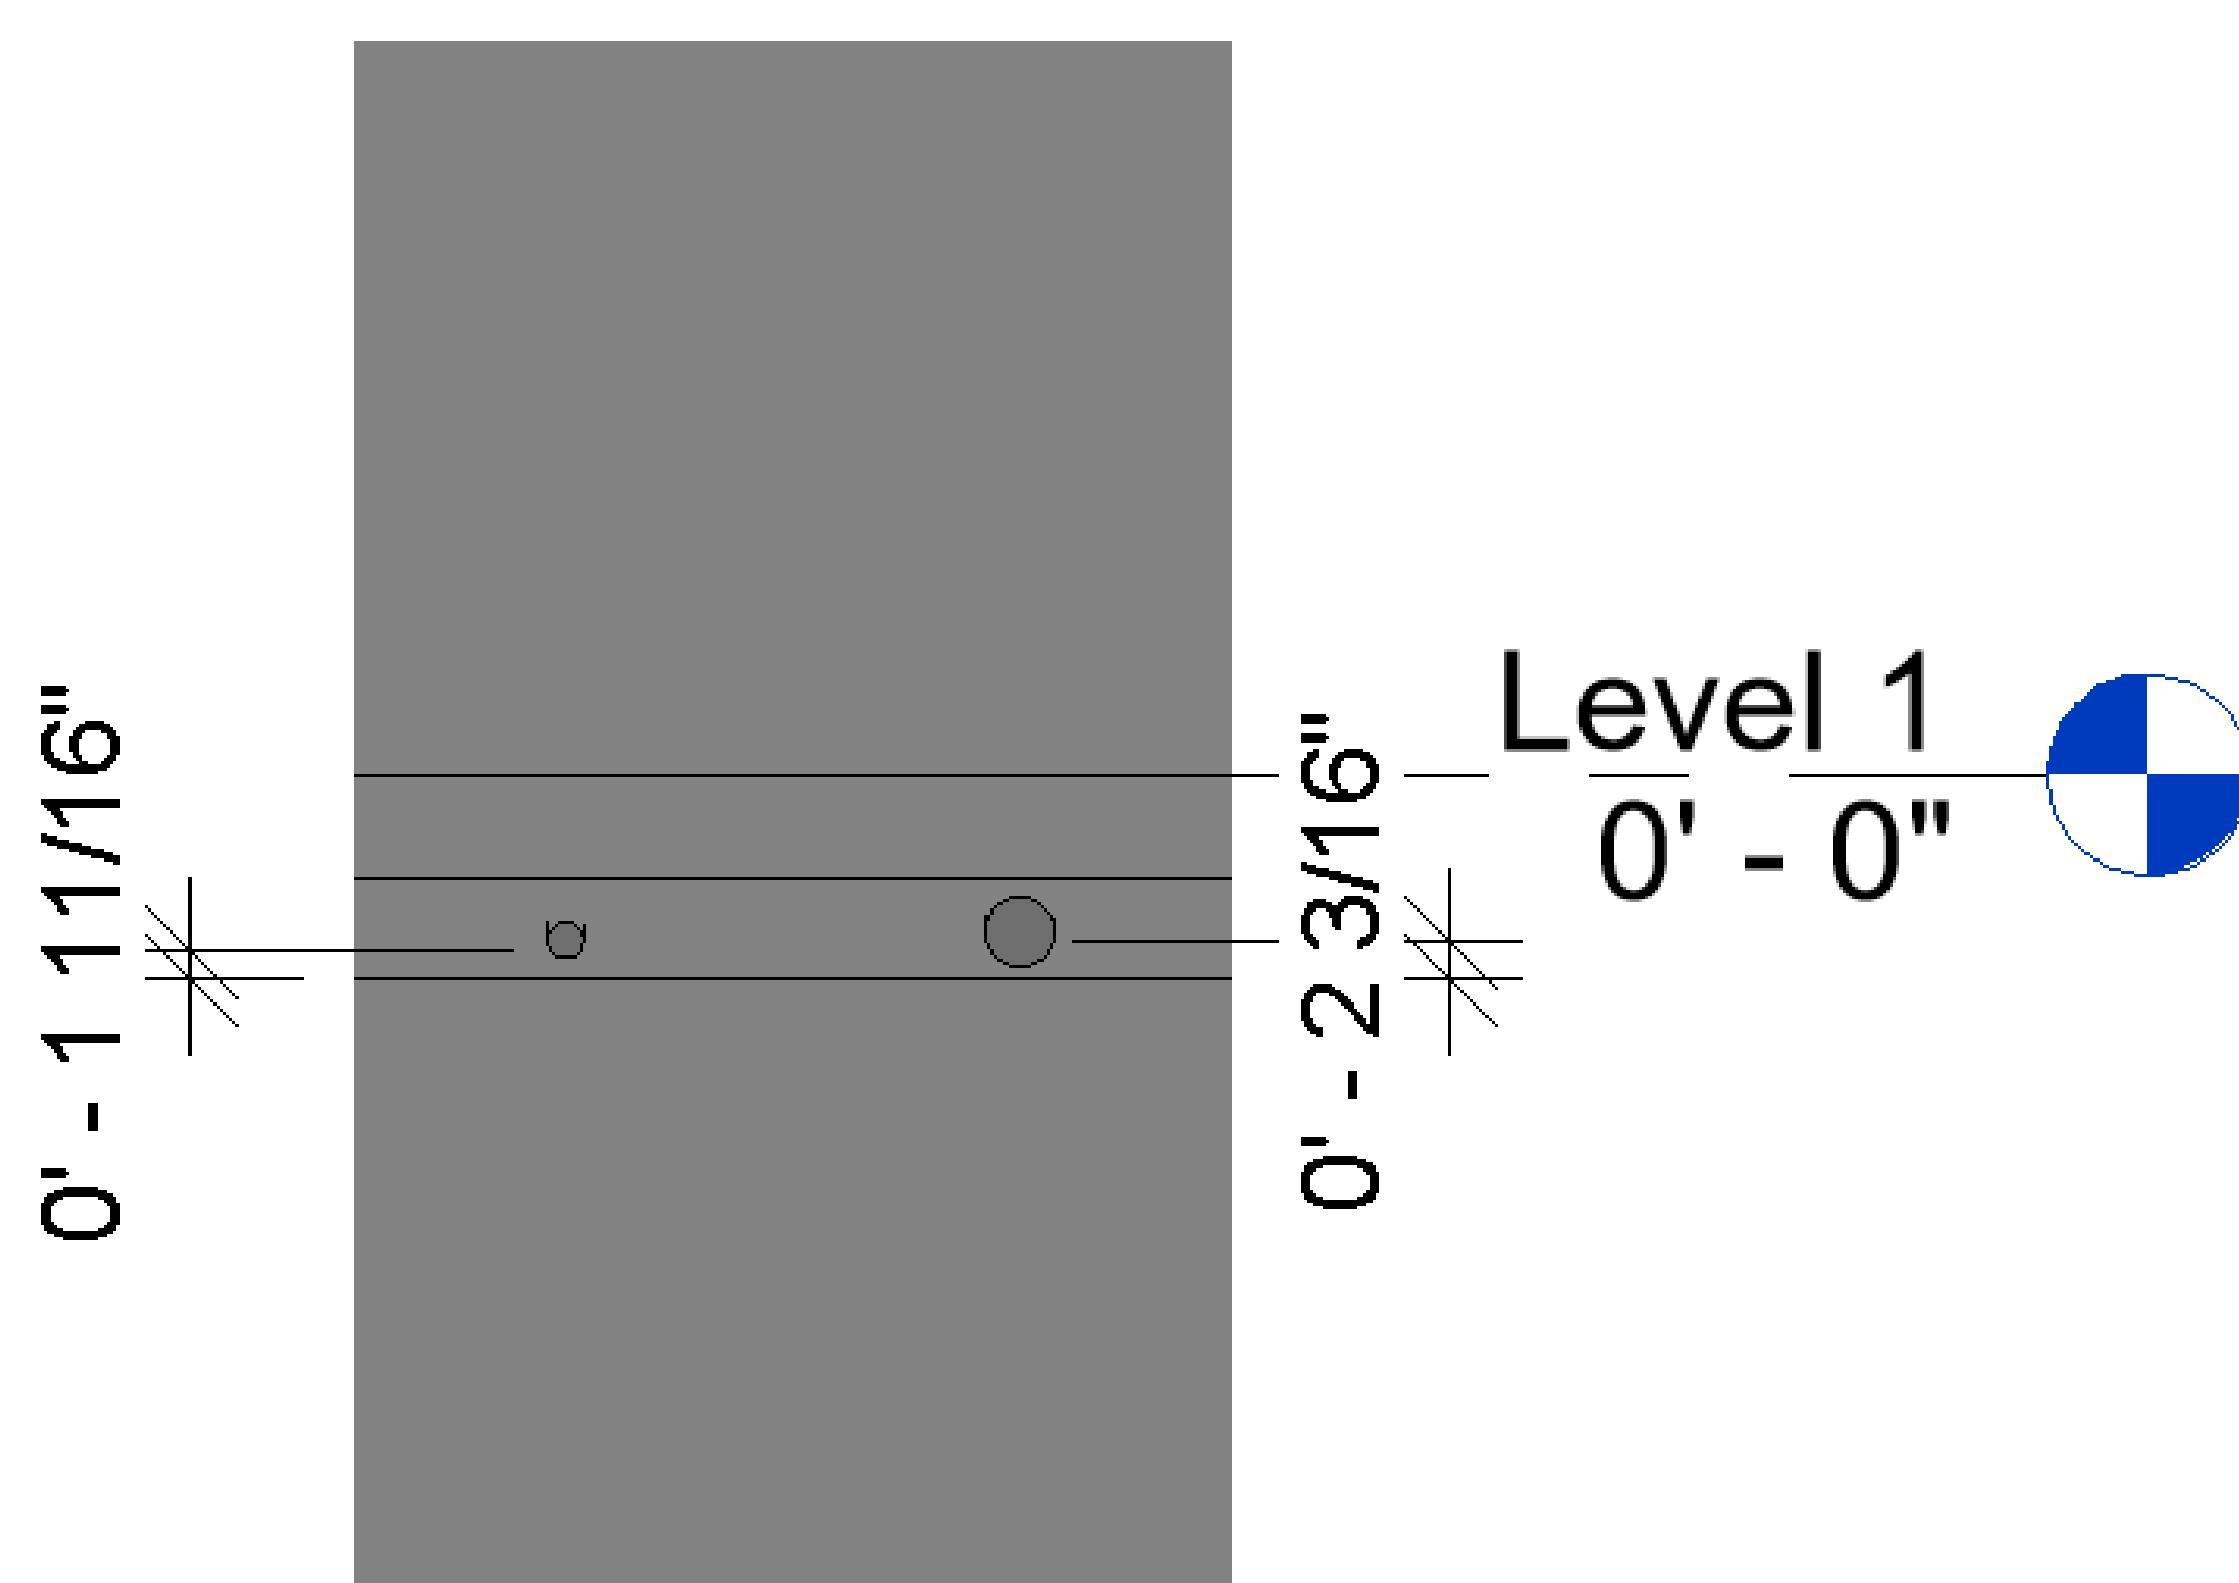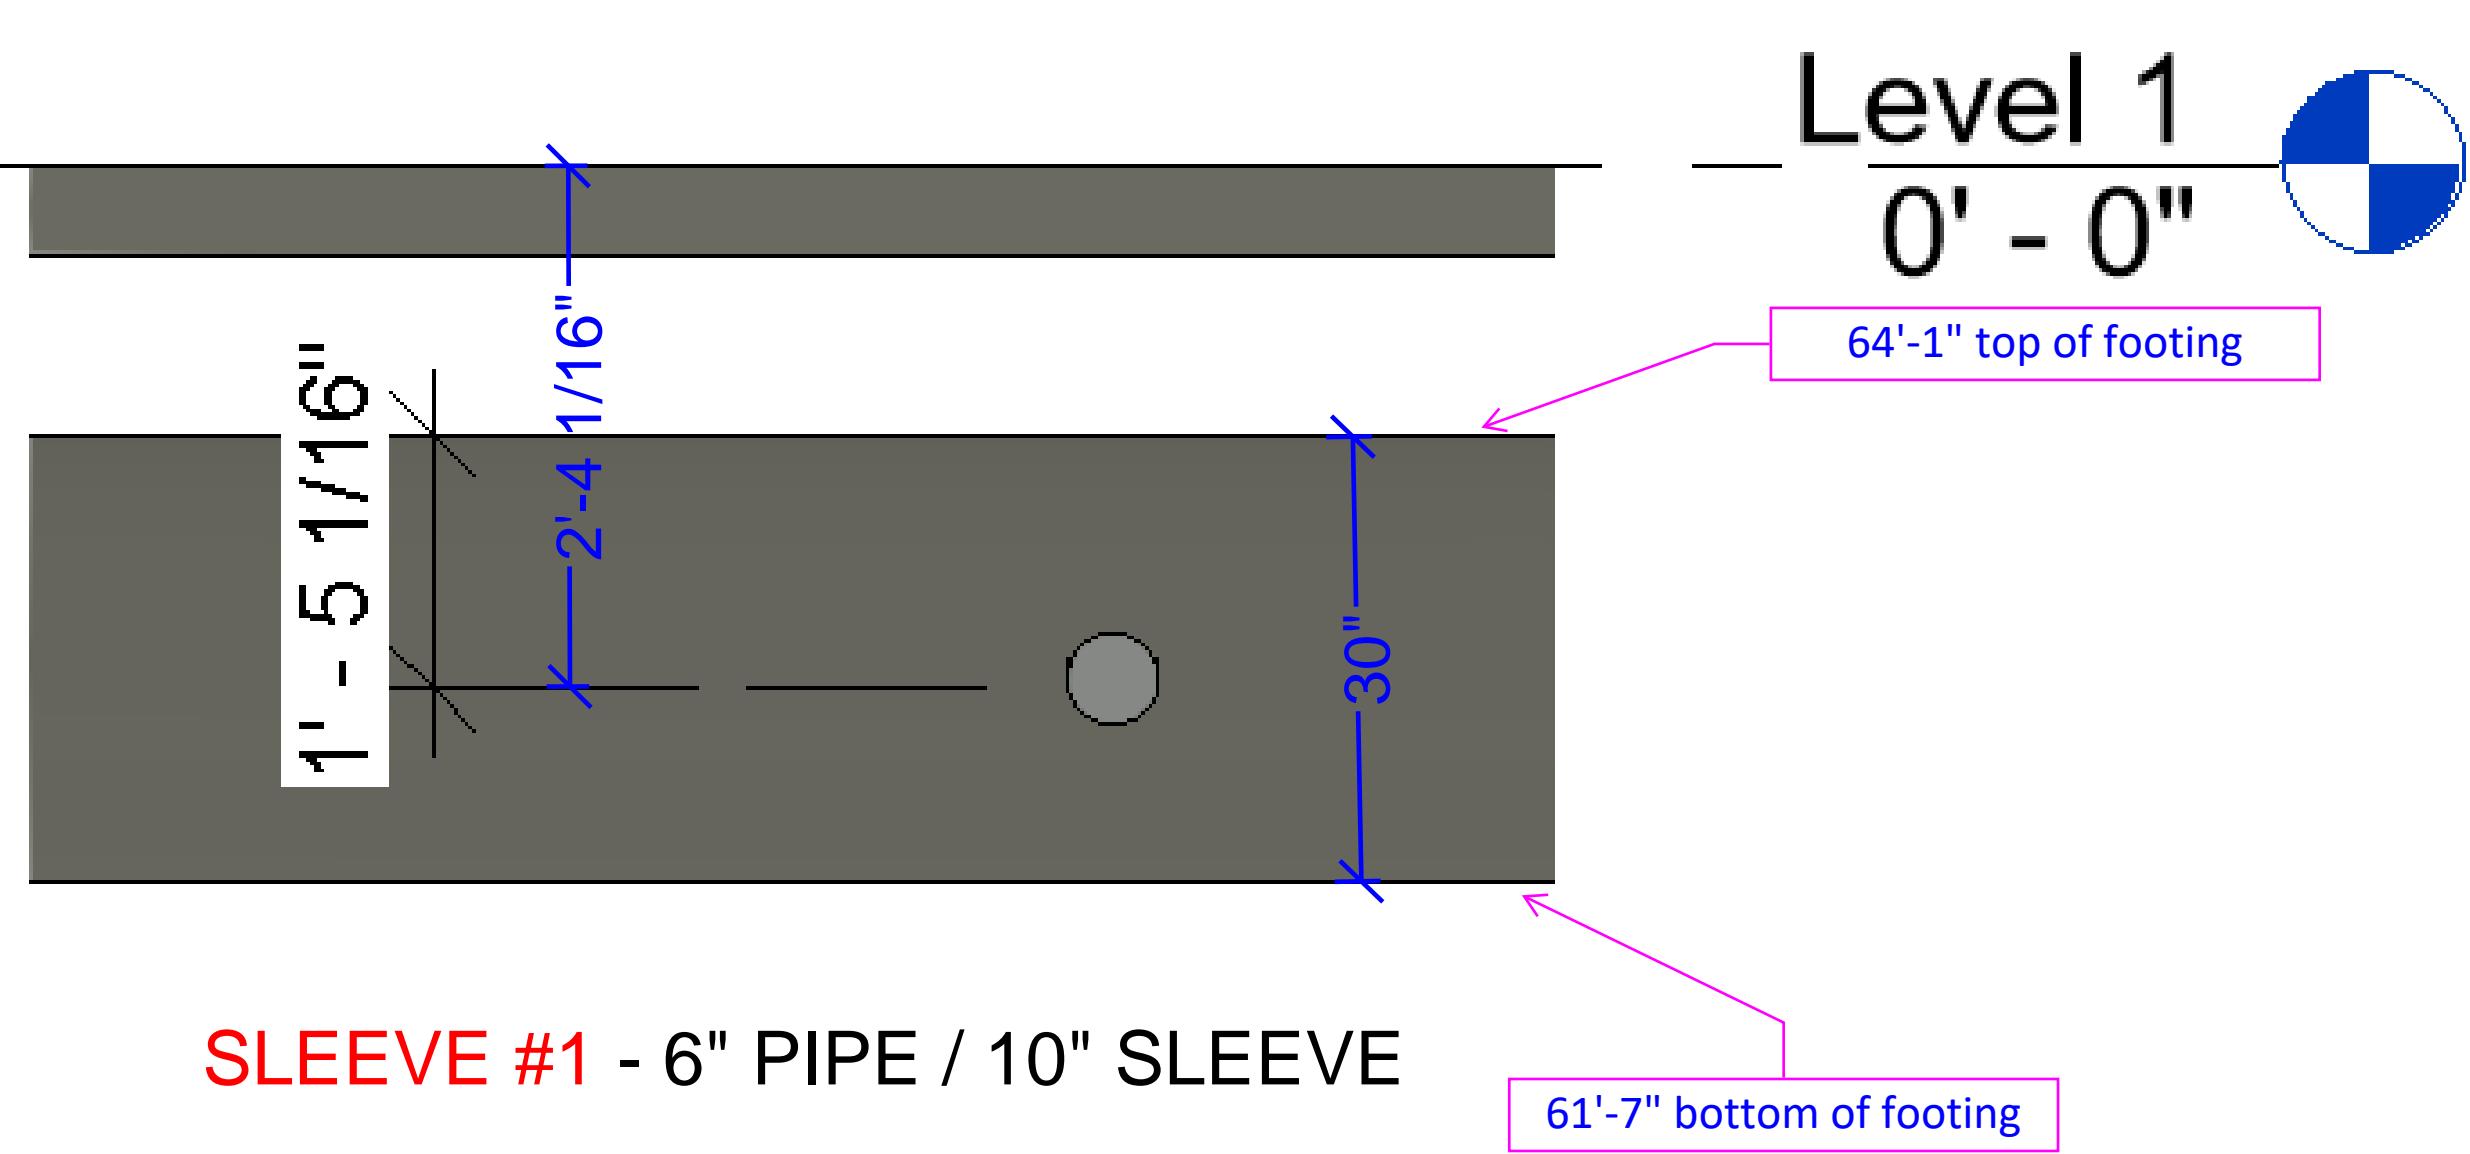

**█████** will prepare Coordination Drawings for the sole purpose of general coordination and conformance with the project requirements and the design intent as indicated in the Contract Documents. These Coordination Drawings shall become Subcontract Documents as defined in the Subcontract Agreement. The work depicted within the Coordination Drawings does not relieve the Subcontractor of the responsibility for compliance with the Subcontract Documents and with any State, Federal or Local jurisdictional requirements. Nor shall these drawings be considered a replacement for the responsibilities associated with fabrication, means, methods, techniques, sequence, operations, erection, performance, or safety of systems that remain the sole responsibility of the Subcontractor. Sole responsibility for correctness of dimensions, details, quantity for fabrication, construction, erection, installation and performance shall remain the sole responsibility of the Subcontractor. By authorizing below, the Subcontractor represents that they have fully reviewed the Coordination Drawings and verify that any and all errors, omissions or discrepancies that they are aware of, have been fully resolved and those resolutions are represented within these Coordination Drawings.

|   |            |
|---|------------|
| MEP TRADES:   | ██████████ |
| PLUMBING:   | ██████████ |
| FIRE PROTECTION:  | ██████████ |
| MECHANICAL -  | ██████████ |
| ELECTRICAL -  | ██████████ |
| SIGNATURES:   | ██████████ |
| Date: Trade: Signature:   | ██████████ |
| SIGNATURE SIGNIFIED ACCEPTANCE OF COORDINATED PLAN AS REVIEW BY EACH RESPECTED TRADE. |            |
| 08/09/2020  | 08         |
| 04/12/2020  | 04         |
| 03/15/2020  | 03         |
| 02/11/2020  | 02         |
| 1/1/2020  | 01         |
| No Date: Revision:  | ██████████ |
| SCALE:  | ██████████ |
| KEY PLAN:   |            |
|   |            |
| DRAWING TITLE:  |            |
| SLEEVE PENETRATIONS   |            |
| PROJECT NO. 01  | 01         |
| DRAWN BY A.V.   | A.V.       |
| CHECKED BY A.P.   | A.P.       |
| ENGINEER REVIEW STAMP:  | CP-06      |
| DWG. NO. CP-06  |            |